

SURVEY & MONUMENTATION

DEC 18 1995

COMMISSION

LAND CORNER RECORDATION CERTIFICATE
Filing Requirement of Act 74, Mich. P.A. 1970


For corners in

MASON (County) Located In: Corner Code #

1. Public Land Survey T 18 N R 16 W K-9
T R
T R
T R

2. Property Controlling S T R
in Section S T R

3. Miscellaneous S T R
Property in Sec. S T R

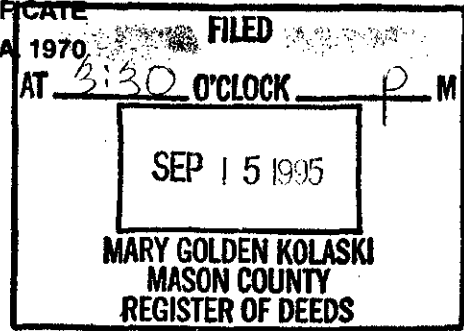

Register of Deeds Stamp & File Number

4. Lot No. _____, Recorded Plat _____
5. Private Claims _____

A	B	C	D	E	F	G	H	I	J	K	L	M
2	6	5	4	3	2	1						
3												
4	7	8	9	10	11	12						
5												
6	18	17	16	15	14	13						
7												
8	19	20	21	22	23	24						
9												
10	30	29	28	27	26	25						
11												
12	31	32	33	34	35	36						
13												

I, Sammy S. Barnett, in a field survey on _____, 1995, do hereby certify that under requirements of P.A. 74, Michigan P.A. of 1970, the corner points mentioned in lines 1 and 2 above were in conformance with regulations and rules therefore as required in the current manual of survey instructions of the United States Department of the Interior, Bureau of Land Management or by a decree of a Court of Law and/or that the corner points mentioned in lines 3, 4 and 5 above were in conformance with the rules of the Michigan Board of Land Surveyors or by a Decree of a Court of Law; established, re-established, monumented, re-monumented, recovered, found as expressed below:

NOTE: Not more than 4 corners, all in the same town and range, may be recorded on this certificate.

A. Description of original monument and accessories and/or subsequent restoration:

K-9 Section Corner for Section 23, 24, 25, and 26, T18N, R16W.

1838, Sylvester Sibley, D.S., G.L.O.

Set Wood Post

#1 Hemlock 14" N 74° W 181ks.(11.88')

#2 Beech 12" S 26° E 351ks.(23.10')

1884, James Jones, D.C.S.

Identify by Gov't "BT'S"

No monument given

1977 & 1991, Ken Ross, M.C.S.

Found 1/2" Iron Rod

#3 Power Pole S 60° W 39.96'

#4 Beech 20" N 17° E 109.29'

#5 Tw. Beech N 65° E 117.58'

#6 Tw. Cherry S 15° E 81.97'

B. Description of corner evidence found and/or method applied in restoring or reestablishing corner:

K-9 Section Corner for Section 23, 24, 25 and 26, T18N, R16W.

On August 9, 1995, I found a 1/2" Re-Rod at the East shoulder of Reek Road, I found no Irons or Markers or any other evidence to dispute this location for the corner.

Condition of Recorded witnesses is; #1 Gone #2 Gone #3 Found in good cond. with USFS tree tag (Griffin)
#4 Found in good cond. #5 Found in good cond. #6 Gone

C. Description of monument for corner and accessories established to perpetuate locating the position of the corner:

K-9 Section Corner for Sections 23, 24, 25 and 26, T18N, R16W.

I, replaced 1/2" Re-Rod with a 5/8" Re-Rod, 24" long, with an aluminum cap stamped, MASON COUNTY MONUMENT I set Monument 0.5' below the surface of the Road (dirt), and is accepted as a careful and faithful reestablishment of the position of the original corner.

- OBT #3 Power Pole S 60° W 38.94' (16p nail w/ shiner on NW side)
- OBT #4 Beech 22" N 17° E 109.29' (60d spike in NW side of tree)
- OBT #5 Tw. Beech 18" N 65° E 117.58' (60d spike in SE side of tree)
- Sugar Maple 7" S 14° E 102.50' (60d spike in SW side of tree)

Signed by Sammy S. Barnett
Surveyor's Michigan License No. 16923

Peer Group Review and Approved Date: 9-8-95
Kenneth L. Ross
Mason County Surveyor

