

DEC 1 8 1995

COMMISSION

LAND CORNER RECORDATION CERTIFICATE

Filing Requirement of Act 74, Mich. P.A. 1970

For corners in


MASON (County)

Located in:

Corner Code #

- 1. Public Land Survey T 18 N R 16 W K-13
T R
T R
T R
- 2. Property Controlling S T R
in Section S T R
- 3. Miscellaneous S T R
Property in Sec. S T R

- 4. Lot No. _____, Recorded Plat _____
- 5. Private Claims _____

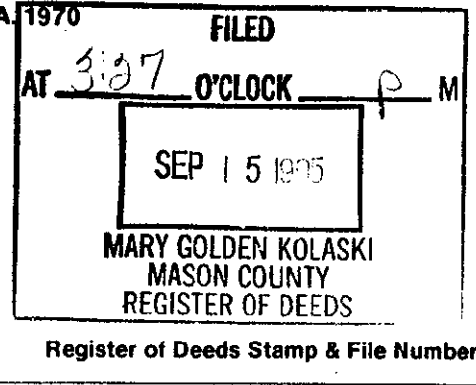

I, Sammy S. Barnett, in a field survey on _____, 19 95, do hereby certify that under requirements of P.A. 74, Michigan P.A. of 1970, the corner points mentioned in lines 1 and 2 above were in conformance with regulations and rules therefore as required in the current manual of survey instructions of the United States Department of the Interior, Bureau of Land Management or by a decree of a Court of Law and/or that the corner points mentioned in lines 3, 4 and 5 above were in conformance with the rules of the Michigan Board of Land Surveyors or by a Decree of a Court of Law; established, re-established, monumented, re-monumented, recovered, found as expressed below:

NOTE: Not more than 4 corners, all in the same town and range, may be recorded on this certificate.

	A	B	C	D	E	F	G	H	I	J	K	L	M
2	6		5		4		3		2		1		
3													
4	7		8		9		10		11		12		
5													
6	18		17		16		15		14		13		
7													
8	19		20		21		22		23		24		
9													
10	30		29		28		27		26		25		
11													
12	31		32		33		34		35		36		
13													

A. Description of original monument and accessories and/or subsequent restoration:
K-13 Section Corner for Sections 35 and 36, T18N, R16W, on the township line.

1838, Mullett & Brookfield, G.L.O.

Set Wood Post

#1 Maple 10" N 40° E 381ks.(25.08')

#2 Beech 6" N 61° W 251ks.(16.5')

1886, W.E. Metcalf, D.C.S.

Monument not given

#3 Pine Stump 20" S 50°30' W 281ks.(18.48')

#4 Pine Stump 26" N 38° W 291ks.(19.14')

1994, Ken Ross, M.C.S.(R. Hepworth)

Set 1/2" Re-Rod.

#5 Tw. Red Oak 22" N 44° W 77.57'

#6 Red Oak 7" N 32° E 29.22'

#7 Maple 24" S 55° W 86.88'

B. Description of corner evidence found and/or method applied in restoring or reestablishing corner:

K-13 Section Corner for Sections 35 and 36, T18N, R16W, on the township line.

On August 9, 1995, I found a 1/2" Re-Rod with a Ross Surveys P.S. cap about 100 feet South of Chauvez Road I search the area for Metcalf's Pine Stumps but found nothing to fit his distance with the given bearings, also found no other Irons or Markers or Witness trees.

Condition of Recorded Witnesses is; #1 Gone #2 Gone #3 Gone #4 Gone #5 Found in good cond.
#6 Found in good cond. #7 Found in good cond.

C. Description of monument for corner and accessories established to perpetuate locating the position of the corner:

K-13 Section Corner for Sections 35 and 36, T18N, R16W, on the township line.

I replaced 1/2" Re-Rod with a 5/8" Re-Rod, 24" long with an aluminum cap stamped MASON COUNTY Monument placed flush with the ground surface, and is accepted as a careful and faithful reestablishment of the position of the original corner.

OBT #5 Tw. Red Oak 22" N 44° W 77.57' (60d spike in NE side of tree)

OBT #6 Red Oak 7" N 32° E 29.22' (60d spike in SE side of tree)

OBT #7 Maple 24" S 55° W 86.88' (60d spike in SE side of tree)

U.S.F.S. Post N 05° E 94.20' (60d spike in West side of post),

MASON COUNTY MONUMENT (aluminum cap) East ~~16.50'~~ 16.50'

Signed by Sammy S. Barnett Peer Group Reviewed Date 9-8-95

Surveyor's Michigan License No. 16923 Dates 7-12-95 and Approved

FORM APPROVED BY MICHIGAN STATE BOARD OF LAND SURVEYORS, JAN. 28, 1971
REVISED MAY 14, 1975
REVISED JAN., 1983



Kenneth L. Ross
Mason County Surveyor