

SURVEY & REMONUMENTATION

FEB 08 2000

LAND CORNER RECORDATION CERTIFICATE

Filing Requirement of Act 74, Mich. P.A. 1976

SECTION


For corners In: Located In: Corner Code #
 Mason County

1. Public Land Survey T 18N R 16W L-1
 T _____ R _____
 T _____ R _____
 T _____ R _____

2. Property Controlling S _____ T _____ R _____
 in Section S _____ T _____ R _____

3. Miscellaneous S _____ T _____ R _____

Property in Sec. S _____ T _____ R _____

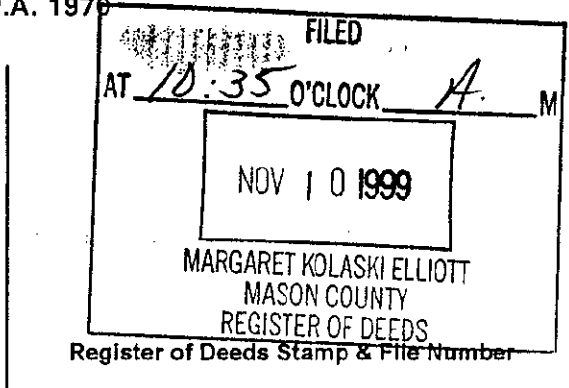

4. Lot No. _____, Recorded Plat _____
 5. Private Claims _____

	A	B	C	D	E	F	G	H	I	J	K	L	M
1													
2	6	5	4	3	2	1							
3													
4	7	8	9	10	11	12							
5													
6	18	17	16	15	14	13							
7													
8	19	20	21	22	23	24							
9													
10	30	29	28	27	26	25							
11													
12	31	32	33	34	35	36							
13													

I, Kenneth L. Ross, in a field survey on October 16, 1999, Do hereby certify that under requirements of P.A. 74, Michigan P.A. of 1970, the corner points mentioned in lines 1 and 2 above were in conformance with regulations and rules therefore as required in the current manual of survey instructions of the United States Department of the Interior, Bureau of Land Management or by a decree of a Court of Law and/or that the corner points mentioned in lines 3, 4 and 5 above were in conformance with the rules of the Michigan Board of Land Surveyors or by a Decree of a Court of Law; established, re-established, monumented, re-monumented, recovered, found as expressed below:

NOTE: Not more than 4 corners, all in the same town and range, may be recorded on this certificate.

A. Description of original monument and accessories and/or subsequent restoration:

N ¼ Corner Section 1, T. 18N., R. 16W.,

Corner not set by GLO W.E. Metcalf, 1896, Book 1, page 312 and 313
 "Set stake midway between NE and NW Corners on line" No Witnesses Given.
 Distance West to K-1, 2632.08'
 Distance East to M-1, 2632.08'

I found no other recorded documentation for this corner.

B. Description of corner evidence found and/or method applied in restoring or reestablishing corner:

N ¼ Corner Section 1, T. 18N., R. 16W.,

I could not locate this corner in the field. I then measured the distance between Corner K-1 and M-1, (5256.92') and prorated the location of this corner based on the above W. E. Metcalf Survey of 1896. As follows:

$$\frac{5264.16}{5256.92'} \times \frac{2632.08}{x} = 2628.46'$$

C. Description of monument for corner and accessories established to perpetuate locating the position of the corner:

N ¼ Corner Section 1, T. 18N., R. 16W.,


I placed a 3" Harrison Cast Iron Monument on a straight line between Corners K-1 and M-1 at the above prorated distance and accepted this location as the best available evidence of the position of the corner.

- (1) L-13, T. 19N., R. 16W., Set 3" Harrison Cast Iron Monument, West, 1.64'
 - (2) N. End of 18" CMP, N18°W, 10.95'
 - (3) S. End of 18" CMP, S15°W, 30.25'
 - (4) Set 60d spike top of Cedar Fence Post, N27°E, 17.28'
 - (5) Set 60d spike top of Cedar Fence Post, N59°E, 28.04'
 - (6) Most Westerly Corner of Permanent Hunters Blind, N14°W, 40.81'
- Center line of two track (Decker Road a certified county road) Not passable, South 8'
 Fence Line to North and East, North 18'
 County Drain, South, 40' (Running East and West)

Signed by [Signature] Date Nov. 4, 1999

Surveyor's Michigan License No. 17634

Approved by Peer Review Group on Nov. 4, 1999
 Kenneth L. Ross, County Representative [Signature]

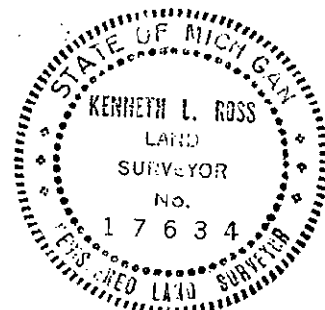

FORM APPROVED BY MICHIGAN STATE BOARD OF LAND SURVEYORS, JAN. 28, 1971
 REVISED MAY 14, 1975
 REVISED JAN., 1983