


**SURVEY &  
REMONUMENTATION**

DEC 18 1995

**LAND CORNER RECORDATION CERTIFICATE**  
COMMISSION Filing Requirement of Act 74, Mich. P.A. 1970

For corners in

<u>MASON</u> (County)	Located In:	Corner Code #
1. Public Land Survey	T <u>18 N</u> R <u>16 W</u>	<u>L-11</u>
	T _____ R _____	_____
	T _____ R _____	_____
	T _____ R _____	_____
2. Property Controlling in Section	S _____ T _____ R _____	_____
	S _____ T _____ R _____	_____
3. Miscellaneous Property in Sec.	S _____ T _____ R _____	_____
	S _____ T _____ R _____	_____
4. Lot No. _____, Recorded Plat _____		
5. Private Claims _____		

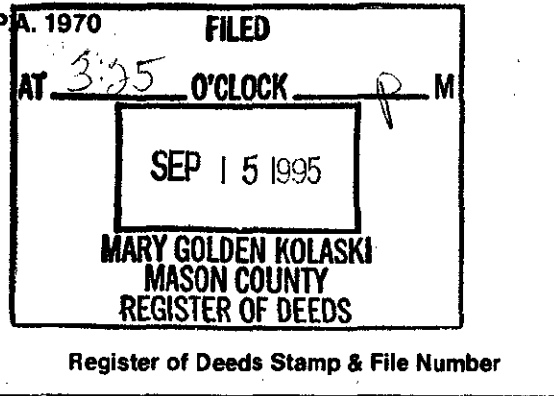

	A	B	C	D	E	F	G	H	I	J	K	L	M
2	6	5	4	3	2	1							
3													
4	7	8	9	10	11	12							
5													
6	18	17	16	15	14	13							
7													
8	19	20	21	22	23	24							
9													
10	30	29	28	27	26	25							
11													
12	31	32	33	34	35	36							
13													

I, Sammy S. Barnett, in a field survey on \_\_\_\_\_, 1995, do hereby certify that under requirements of P.A. 74, Michigan P.A. of 1970, the corner points mentioned in lines 1 and 2 above were in conformance with regulations and rules therefore as required in the current manual of survey instructions of the United States Department of the Interior, Bureau of Land Management or by a decree of a Court of Law and/or that the corner points mentioned in lines 3, 4 and 5 above were in conformance with the rules of the Michigan Board of Land Surveyors or by a Decree of a Court of Law; established, re-established, monumented, re-monumented, recovered, found as expressed below:

**NOTE: Not more than 4 corners, all in the same town and range, may be recorded on this certificate.**

**A. Description of original monument and accessories and/or subsequent restoration:**

L-11 1/4 Corner for Sections 25 and 36, T18N, R16W.

1838, Sylvester Sibley, D.S., G.L.O.  
Used 18" Pine for Corner

1991, 1993 & 1994, Ken Ross, M.C.S.  
Found 1 1/4" Iron Pipe (well point)  
#1 Fence Post @ gate S 83° E 24.30'  
#2 Tri. W. Oak S 05° E 83.29' 12" trees  
#3 W. Oak 28" N 30° W 73.73'  
#4 Tw. W. Oak 16" S 73° W 109.53'

**B. Description of corner evidence found and/or method applied in restoring or reestablishing corner:**

L-11 1/4 Corner for Sections 25 and 36, T18N, R16W.

On August 9, 1995, I found a 1 1/4" Iron Pipe (well point) at the East shoulder of Pöplar Road 0.2' below road surface, found no other Iron or marker, or any other evidence to dispute this location.

Condition of Recorded Witnesses is; #1 Found in good cond. #2 Found in good cond. #3 Found in good cond. #4 Found in good cond.

**C. Description of monument for corner and accessories established to perpetuate locating the position of the corner:**

L-11 1/4 Corner for Sections 25 and 36, T18N, R16W.


I replaced Well Point with a 5/8" Re-Rod, 24" long, with an aluminum cap stamped MASON COUNTY MONUMENT I placed Monument 0.5' below surface of the road (dirt), and is accepted as a careful and faithful reestablishment of the position of the original corner.

- OBT #1 Fence Post @ gate S 83° E 24.30' (60d spike in the SW side of Post)
- OBT #2 Tri. White Oak 13" S 15° E 83.29' (60d spike in SW side of tree)
- OBT #3 White Oak 30" N 30° W 73.73' (60d spike in SW side side)
- OBT #4 Tw. White Oak 16" S 73° W 109.53' (60d spike in the NW side of tree)

Signed by Sammy S. Barnett Date 9-8-95

Surveyor's Michigan License No. 16923

Peer Group Reviewed  
and Approved  
Date: 9-12-95  
Kenneth L. Ross  
Mason County Surveyor

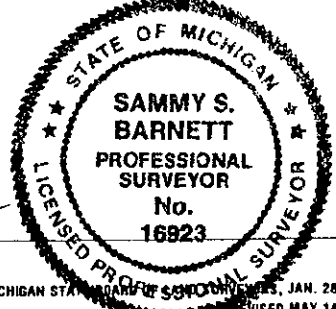

FORM APPROVED BY MICHIGAN STATE BOARD OF SURVEYORS, JAN. 28, 1971  
REVISED MAY 14, 1975  
REVISED JAN., 1983