

**SURVEY & REMONUMENTATION**


MAR 16 1998

**LAND CORNER RECORDATION CERTIFICATE**  
Filing Requirement of Act 74, Mich. P.A. 1970

For corner SECTION

MASON (County) Located In: Corner Code #

1. Public Land Survey	T 18N R 17W	A-1
	T R	
	T R	
	T R	
2. Property Controlling in Section	S T R	Seg. 2
	S T R	
3. Miscellaneous Property in Sec.	S T R	
	S T R	

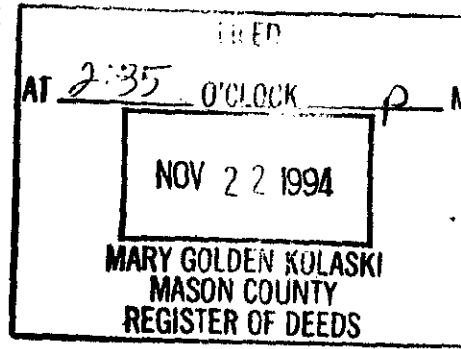

Register of Deeds Stamp & File Number

4. Lot No. \_\_\_\_\_, Recorded Plat \_\_\_\_\_  
5. Private Claims \_\_\_\_\_

I, Theodore H. Weinert, in a field survey on JULY, 1994, do hereby certify that under requirements of P.A. 74, Michigan P.A. of 1970, the corner points mentioned in lines 1 and 2 above were in conformance with regulations and rules therefore as required in the current manual of survey instructions of the United States Department of the Interior, Bureau of Land Management or by a decree of a Court of Law and/or that the corner points mentioned in lines 3, 4 and 5 above were in conformance with the rules of the Michigan Board of Land Surveyors or by a Decree of a Court of Law; established, re-established, monumented, re-monumented, recovered, found as expressed below:

	A	B	C	D	E	F	G	H	I	J	K	L	M
2	6	5	4	3	2	1							
3													
4	7	8	9	10	11	12							
5													
6	18	17	16	15	14	13							
7													
8	19	20	21	22	23	24							
9													
10	30	29	28	27	26	25							
11													
12	31	32	33	34	35	36							
13													

**NOTE: Not more than 4 corners, all in the same town and range, may be recorded on this certificate.**

**A. Description of original monument and accessories and/or subsequent restoration:**

A-1 Section Corner Common to T.18 & 19N.; R.17 & 18W.  
G.L.O. Notes Set Post 1838 Sylvester Sibley W. Pine N 75 E 19 lks W. Pine S 86 W 54 lks December, 1894, & April 7-8, 1895, J. A. Mitchell Tied into corner without stating what was found, then ran north line of section 1, T18N, R18W (Book 1, Page 285 & Book 1, Page 287)


1959 Kenneth Stephens tied into corner August 21, 1975, James T. Nordlund, PLS, tied into corner October 4, 1977, Ken Ross, PLS, tied into corner June 6, 1978, Ken Ross, PLS, Pd 3/4" pipe & filed LCRC (Liber 2, Page 26) 24" Maple NE 32.85' 12" Maple NNW 20.55' 8" Tw Maple S 43.22'

**B. Description of corner evidence found and/or method applied in restoring or reestablishing corner:**

A-1 Section Corner Common to T.18 & 19N.; R.17 & 18W.  
Found 1" X 24" pipe.  
Fit witnesses as recorded by Ken Ross, PLS.  
Fit distances as described by Ken Ross, PLS.  
This corner location is accepted as a careful and faithful perpetuation of the original corner.

**C. Description of monument for corner and accessories established to perpetuate locating the position of the corner:**

A-1 Section Corner Common to T.18 & 19N.; R.17 & 18W.  
Replaced 1" X 24" pipe with 5/8" X 36" rebar with standard 2 1/2" cap stamped "Mason County Remonumentation".  
28" Maple N 53 E 32.89'  
15" Maple N 27 W 20.52'  
Spike in Power Pole N 62 W 107.72'  
12" W. Pine S 64 W 59.58'  
Tw Maple S 06 W 43.22'

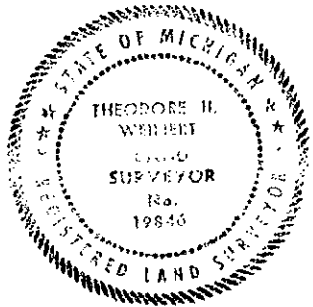

Signed by Theodore H. Weinert Date 10/4/94  
Surveyor's Michigan License No. 19846

FORM APPROVED BY MICHIGAN STATE BOARD OF LAND SURVEYORS, JAN. 28, 1971  
Peer Group Reviewed and Approved Date: 10-5-94  
Peer Group Reviewed and Approved Date: Feb 23 1997  
Kenneth I. Ross