

SURVEY & REMONUMENTATION

JAN 23 2001

SECTION LAND CORNER RECORDATION CERTIFICATE
 Filing Requirement of Act 74, Mich. P.A. 1970

For corners In: Located In: Corner Code #
 Mason County

Public Land Survey T 18N R 17W A-2 ✓
 T 18N R 18W M-2
 T R
 T R
 Property Controlling S T R
 in Section S T R
 Miscellaneous S T R
 Property in Sec. S T R

FILED
 AT 9:34 O'CLOCK A M
 AUG 17 2000
 MARGARET KOLASKI ELLIOTT
 MASON COUNTY
 REGISTER OF DEEDS
 Register of Deeds Stamp & File Number

Lot No. Recorded Plat
 Private Claims

Kenneth L. Ross in a field survey on June 14, 2000, Do hereby certify that under requirements of P.A.74, Michigan P.A. of 1970, the corner points mentioned in lines 1 and 2 above were in conformance with regulations and rules therefore as required in the current manual of survey instructions of the United States Department of the Interior, Bureau of Land Management or by a decree of a Court of Law and/or that the corner points mentioned in lines 3, 4 and 5 above were in conformance with the rules of the Michigan Board of Land Surveyors or by a Decree of a Court of Law; established, re-established, monumented, re-monumented, recovered, found as expressed below:

4 corner common to section 6, T18N, R17W, and Section 1, T18N, R18W

A. Description of original monument and accessories and/or subsequent restoration:

- Mullett & Brookfield 1838
- Set 1/4 Sec. post
- Treech 14 S65W 20 lks. (13.20') #1
- Treech 14 N29W 26 lks. (17.16') #2
- Ross PLS 17634 1977 Set 1" pipe
- by single proportionate measurement between A-1 & A-3 of T18N, R17W
- 2.6 ft. North of fence intersection. Fence to north and East.
- 18" Hemlock S25W 19.95' #3
- 14" W. Pine S10E 48.31' #4
- 12" Maple S60E 31.76' #5
- 12" Tw. Maple N30W 30.81' #6

This corner position has been used in several boundary surveys by Ross and Nordlund.

B. Description of corner evidence found and/or method applied in restoring or reestablishing corner:

I found a 1" X 18" pipe on a N-S fence and a fence to the East.
 Condition of the accessories: 1 and 2 are gone, 3, 4, 5, and 6 are in good condition.
 I found nothing to dispute the location of this corner.

C. Description of monument for corner and accessories established to perpetuate locating the position of the corner:

I replace the 1" pipe with a Harrison Monument stamped "Mason County Monument 17634". I accepted this as a careful and faithful reestablishment of the position of the original corner.


- 2.6 ft. North of fence intersection. Fence to north and East.
- 20" Hemlock S25W 19.95' #3
- 16" W. Pine S10E 48.31' #4
- 14" Maple S60E 31.76' #5
- 15" Tw. Maple N30W 30.81' #6

Signed by [Signature] Date 8-10-2000

Surveyor's Michigan License No. 17634

Approved by Peer Review Group on 8-10-2000
 Kenneth L. Ross, County Representative [Signature]

	A	B	C	D	E	F	G	H	I	J	K	L	M
20	6	5	4	3	2	1							
3													
4	7	8	9	10	11	12							
5													
6	18	17	16	15	14	13							
7													
8	19	20	21	22	23	24							
9													
10	30	29	28	27	26	25							
11													
12	31	32	33	34	35	36							
13													

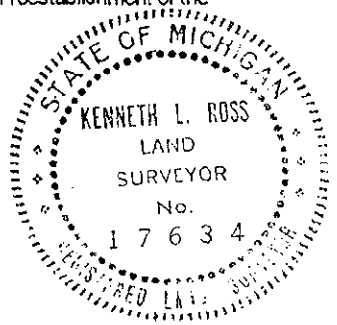

FORM APPROVED BY MICHIGAN STATE BOARD OF LAND SURVEYORS, JAN. 28,
 1971
 REVISED MAY 14, 1976
 REVISED JAN., 1983
 ADAPTED FOR WORD PROCESSING MARCH, 1993