


SURVEY &
REMONUMENTATION

DEC 18 1995

COMMISSION LAND CORNER RECORDATION CERTIFICATE
Filing Requirement of Act 74, Mich. P.A. 1970

For corners in

MASON (County)	Located In:	Corner Code #
1. Public Land Survey	T 18 N R 17 W	B-3
	T _____ R _____	_____
	T _____ R _____	_____
	T _____ R _____	_____
2. Property Controlling in Section	S _____ T _____ R _____	_____
	S _____ T _____ R _____	_____
3. Miscellaneous Property in Sec.	S _____ T _____ R _____	_____
	S _____ T _____ R _____	_____
4. Lot No. _____, Recorded Plat _____		
5. Private Claims _____		

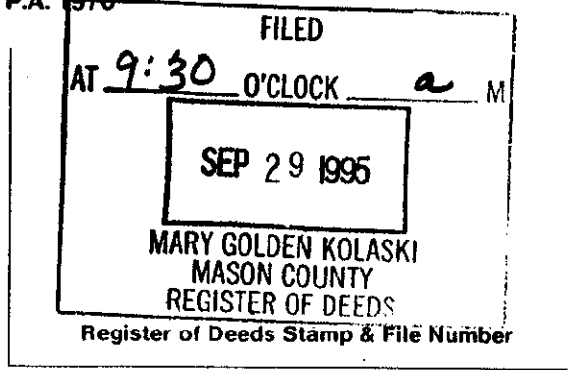

I, Sammy S. Barnett, in a field survey on SEPTEMBER, 1995, do hereby certify that under requirements of P.A. 74, Michigan P.A. of 1970, the corner points mentioned in lines 1 and 2 above were in conformance with regulations and rules therefore as required in the current manual of survey instructions of the United States Department of the Interior, Bureau of Land Management or by a decree of a Court of Law and/or that the corner points mentioned in lines 3, 4 and 5 above were in conformance with the rules of the Michigan Board of Land Surveyors or by a Decree of a Court of Law, established, re-established, monumented, re-monumented, recovered, found as expressed below:

NOTE: Not more than 4 corners, all in the same town and range, may be recorded on this certificate.

	A	B	C	D	E	F	G	H	I	J	K	L	M
2	6	5	4	3	2	1							
3	•												
4	7	8	9	10	11	12							
5													
6	18	17	16	15	14	13							
7													
8	19	20	21	22	23	24							
9													
10	30	29	28	27	26	25							
11													
12	31	32	33	34	35	36							
13													

A. Description of original monument and accessories and/or subsequent restoration:

B-3 1/4 Corner for Sections 6 & 7, T18N, R17W

1838, Sylvester Sibley, DS, G.L.O.
Set Wood Post
#1 Beech 16" N42°W 251k.(16.50')
#2 Hemlock 8" S40°E 131k.8.50')
1916, C.E. Mitchell, MCS
Identified corner as a stone
no witnesses

No Date, M.C.R.C.
Found 1/2" Iron
#3 Power Pole NNW 75.2'
#4 Spruce 8" SSW 31.0'
#5 Old Pump SW 107'
1969, Joe Borsfay, M.C.R.C.
Found 1/2" Iron
#6 Fence Cor. NW 65.57'

#7 Power Pole NNE 75.25'
#8 Spruce 8" SSW 31.81'
1974, Ken Ross, MCS,
Found 1" Pin
#9 Spruce 20" S15°W 75.20'
#10 Power Pole N15°W 75.20'
#11 Hand Pump S70°W 107.11'

B. Description of corner evidence found and/or method applied in restoring or reestablishing corner:

B-3 1/4 Corner for Sections 6 & 7, T18N, R17W

On September 14, 1995, I found a 1" Drift Pin, bent side ways under a road monument box, 1" Drift Pin fit record witness, found no other evidence to disputed this location for the corner.

Condition of recorded witnesses is; #1 Gone #2 Gone #3 Found in good cond. #4 Gone
#5 Found in good cond. #6 Gone #7 Same AS #3 #8 Same as #4 #9 Gone #10 Same as 3
#11 Same as 5

C. Description of monument for corner and accessories established to perpetuate locating the position of the corner:

B-3 1/4 Corner for Sections 6 & 7, T18N, R17W

I placed 5/8" Re-rod inside the center of existing monument box, with an aluminum cap(2 1/2" in dia.), stamped MASON COUNTY MONUMENT, and is accepted as a careful and faithful reestablishment of the position of the original corner.

OBT #3 Power Pole N 15° W 75.02'(60d spike in NE side of Pole)
OBT #5 Center of vertical Pipe @ Hand Pump S 70° W 107.11'
Witness Iron(1/2" Re-rod with RLS Cap #16923) N 55° E 50.67'
"X" on top of culvert(12", metal) S 40° E 39.26'



Signed by Sammy S. Barnett

Surveyor's Michigan License No. 16923

Date 9-26-95
Peer Group Reviewed and Approved
Date: 9-26-95
Kenneth L. Ross
Mason County Surveyor

FORM APPROVED BY MICHIGAN STATE BOARD OF LAND SURVEYORS, JAN. 28, 1971
REVISED MAY 14, 1975
REVISED JAN., 1983