


SURVEY & REMONUMENTATION

APR 28 1995

COMMISSION

LAND CORNER RECORDATION CERTIFICATE Filing Requirement of Act 74, Mich. P.A. 1970

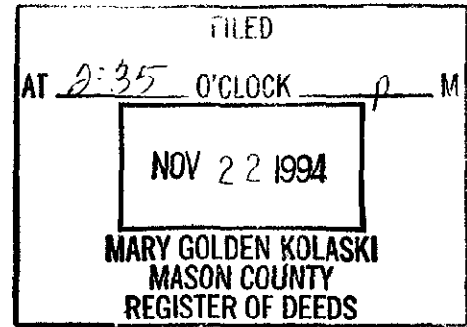

For corners in

MASON <small>(County)</small>	Located In:	Corner Code <i>##</i>
1. Public Land Survey	T <u>18N</u> R <u>17W</u>	C-1
	T _____ R _____	
	T _____ R _____	
	T _____ R _____	<i>Seg. 1</i>
2. Property Controlling in Section	S _____ T _____ R _____	
	S _____ T _____ R _____	
3. Miscellaneous Property in Sec.	S _____ T _____ R _____	
	S _____ T _____ R _____	
4. Lot No. _____, Recorded Plat _____		
5. Private Claims _____		

Register of Deeds Stamp & File Number

	A	B	C	D	E	F	G	H	I	J	K	L	M
2	6	5	4	3	2	1							
3													
4	7	8	9	10	11	12							
5													
6	18	17	16	15	14	13							
7													
8	19	20	21	22	23	24							
9													
10	30	29	28	27	26	25							
11													
12	31	32	33	34	35	36							
13													

I, Theodore H. Weinert, in a field survey on JULY, 1994, do hereby certify that under requirements of P.A. 74, Michigan P.A. of 1970, the corner points mentioned in lines 1 and 2 above were in conformance with regulations and rules therefore as required in the current manual of survey instructions of the United States Department of the Interior, Bureau of Land Management or by a decree of a Court of Law and/or that the corner points mentioned in lines 3, 4 and 5 above were in conformance with the rules of the Michigan Board of Land Surveyors or by a Decree of a Court of Law; established, re-established, monumented, re-monumented, recovered, found as expressed below:

NOTE: Not more than 4 corners, all in the same town and range, may be recorded on this certificate.

A. Description of original monument and accessories and/or subsequent restoration:


<p>C-1 Section Corner, Secs. 5 & 6 G.L.O. Notes Set Post in Cedar swamp September, 1838, Sylvester Sibley 12" Birch Common to Sections 5 & 6 December, 1899, R. O. Towns in survey of Sec 5, T18N, R17W, Ed stake and stump of birch 65 lks (42.90') East of the corner common to Secs 31 & 32, T19N, R18W (Book 2, Page 4)</p>	<p>October 4, 1977, Ken Ross, PLS, reestablished this. corner and set a well point 1 1/4" 36" Maple S 45 W 28.15' 8" Tw Maple N 05 E 23.21' 8" Cedar S 84 W 150.10' Ex. Pipe East 56.06' (Liber 2, Page 25, Mason County Records)</p>
---	---

B. Description of corner evidence found and/or method applied in restoring or reestablishing corner:

C-1 Section Corner, Secs. 5 & 6
Found 1 1/4" well point as set by Ken Ross, PLS.
No witnesses remaining except the called out Cedar
bearing 150.10'; this Cedar turned out to be a
Hemlock. The pipe described as being due west
56.06' was not found. This corner lies on the
easterly edge of a small stream approximately 4.0'
wide.
This corner location is accepted as a careful and
faithful perpetuation of the original corner.

C. Description of monument for corner and accessories established to perpetuate locating the position of the corner:

C-1 Section Corner, Secs. 5 & 6
Set 1" X 6' I.D. pipe with 5/8" X 18" rebar set
inside with standard 2 1/2" cap stamped "Mason
County Remonumentation".
Cedar Post N 43 E 4.50'
Cedar Post N 30 W 6.00'
14" Hemlock S 84 W 149.59'
Corner Common to Sections 31 & 32, T19N, R17W,
West 42.90'

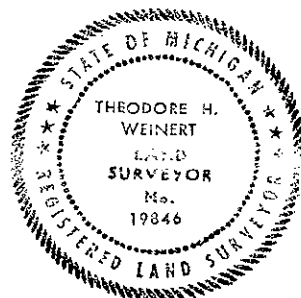

Signed by Theodore H. Weinert
Surveyor's Michigan License No. 19846

Date 10/14/94