

SURVEY & REMONUMENTATION

DEC 18 1995

COMMISSION LAND CORNER RECORDATION CERTIFICATE

Filing Requirement of Act 74, Mich. P.A. 1970


For corners in

MASON (County) Located In: Corner Code #

1. Public Land Survey T 18 N R 17 W C-3
 T R
 T R
 T R

2. Property Controlling S T R
 in Section S T R

3. Miscellaneous S T R
 Property in Sec. S T R

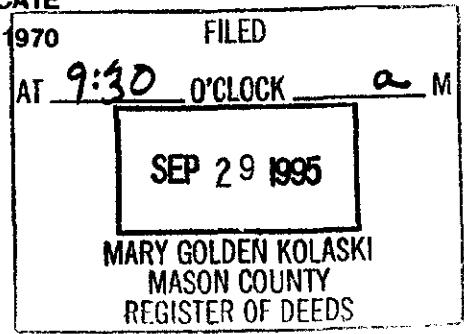

4. Lot No. _____, Recorded Plat _____
 5. Private Claims _____

I, Sammy S. Barnett, in a field survey on September 26, 19 95, do hereby certify that under requirements of P.A. 74, Michigan P.A. of 1970, the corner points mentioned in lines 1 and 2 above were in conformance with regulations and rules therefore as required in the current manual of survey instructions of the United States Department of the Interior, Bureau of Land Management or by a decree of a Court of Law and/or that the corner points mentioned in lines 3, 4 and 5 above were in conformance with the rules of the Michigan Board of Land Surveyors or by a Decree of a Court of Law; established, re-established, monumented, re-monumented, recovered, found as expressed below:

NOTE: Not more than 4 corners, all in the same town and range, may be recorded on this certificate.

A	B	C	D	E	F	G	H	I	J	K	L	M
2	6	5	4	3	2	1						
3		●										
4	7	8	9	10	11	12						
5												
6	18	17	16	15	14	13						
7												
8	19	20	21	22	23	24						
9												
10	30	29	28	27	26	25						
11												
12	31	32	33	34	35	36						
13												

A. Description of original monument and accessories and/or subsequent restoration:

C-3 Section corner for Sections 5, 6, 7 and 8, T18N, R17W

1838, Sylvester Sibley, DS, G.L.O.
 Set Wood Post
 #1 Beech 14" S71°E 291k.(19.14')
 #2 Beech 14" N14°W 381k.(25.08')

1916, C.E. Mitchell MCS
 Identified as a stone
1958, M.C.R.C.
 Found Iron, raised with 3/4" Pipe
 #3 Cherry 10" North, 52.80'
 #4 Power Pole NE 100.90'
 #5 E-W Power line N 28.50'

1973, Ken Ross, MCS
 Found "T" Iron
 #6 Cherry 16" North 53.47'
 #7 Tw. Maple 4" South 34.29'
 #8 Power Pole N70°E 120.06'

B. Description of corner evidence found and/or method applied in restoring or reestablishing corner:

C-3 Section corner for Sections 5, 6, 7 and 8, T18N, R17W

On September 26, 1995, I found a "T" Iron inside a monument box, 1 foot North of the center-line of Hansen Road, this location fit, found existing record witnesses. I found no evidence to disput this location for the corner.

Condition of Recorded witnesses is; #1 Gone #2 Gone #3 Found in good cond. #4 Gone #5 OK
 #6 Same as 3 #7 Found in good cond. #8 Gone

C. Description of monument for corner and accessories established to perpetuate locating the position of the corner:

C-3 Section corner for Sections 5, 6, 7 and 8, T18N, R17W

I replaced "T" Iron with a 5/8" re-rod, 24" long, with an aluminum cap(2 1/2" in dia.), stamped MASON COUNTY MONUMENT, I placed monument inside the existing road monument box, and is accepted as a careful and faithful reestablishment of the position of the original corner.

DBI #3 Cherry 12" North 53.42'(60d spike in East side of tree)
 DBI #7 Tw. Maple 10"-8" South 34.29'(60d spike in East side of tree)
 Power Pole N 45° W 42.90'(PK nail in NE side of pole)
 White Pine 8" S 45° E 64.31'(60d spike in SW side of tree)

Signed by Sammy S. Barnett Peer Group Reviewed Date 9-28-95
 and Approved

Surveyor's Michigan License No. 16923 Date: 9-28-95

