

DEC 18 1995

COMMISSION

LAND CORNER RECORDATION CERTIFICATE

Filing Requirement of Act 74, Mich. P.A. 1970

For corners in


MASON
(County)

Located In:

Corner Code #


- 1. Public Land Survey T 18 N R 17 W D-3
T R
T R
T R
- 2. Property Controlling S T R
in Section S T R
- 3. Miscellaneous S T R
Property in Sec. S T R

- 4. Lot No. _____, Recorded Plat _____
- 5. Private Claims _____

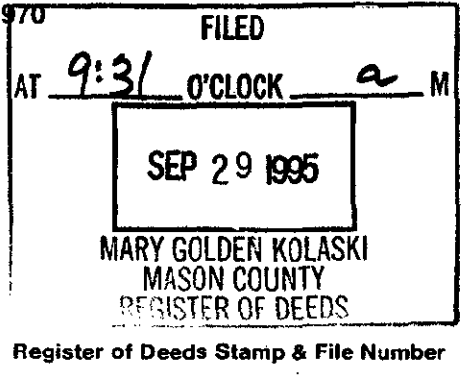

I, Sammy S. Barnett, in a field survey on September 16, 19 95, do hereby certify that under requirements of P.A. 74, Michigan P.A. of 1970, the corner points mentioned in lines 1 and 2 above were in conformance with regulations and rules therefore as required in the current manual of survey instructions of the United States Department of the Interior, Bureau of Land Management or by a decree of a Court of Law and/or that the corner points mentioned in lines 3, 4 and 5 above were in conformance with the rules of the Michigan Board of Land Surveyors or by a Decree of a Court of Law; established, re-established, monumented, re-monumented, recovered, found as expressed below.

NOTE: Not more than 4 corners, all in the same town and range, may be recorded on this certificate.

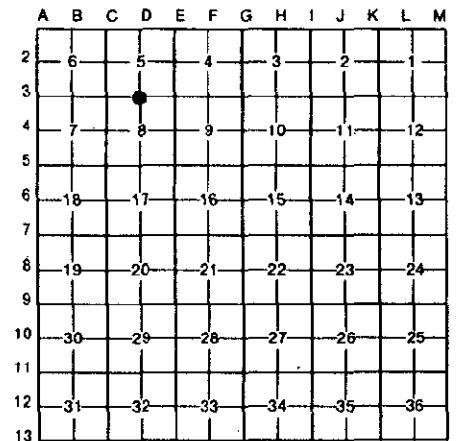

A. Description of original monument and accessories and/or subsequent restoration:

D-3 1/4 Corner for Sections 5 and 8, T18N, R17W

1838, Sylvester Sibley, DS, G.L.O.
Set Wood Posts
#1 Hemlock 12" N37°W 141k.(9.24')
#2 Beech 10" South 241k.(15.84')

1969, M.C.R.C.
Found angle Iron
#4 Center-line Road 107.98' South

1992, Ted Weinert, RLS
Set 5/8" x 24" Re-rod from Ken Ross surveys
#5 Cedar 8" N36°09' W 90.21'
#6 Power Pole N78°W 201.90'
#7 Cen-line of relocated Hasen Rd. South 56.9'
#8 Guard Rail(south face) South 37.8'

1887, J.A. Mitchell, MCS
monument not given, found old witness tree
#3 Center-line of Highway South 2.35 chain(155.1')

1973, Ken Ross, MCS
Found "T" Iron
no witness

B. Description of corner evidence found and/or method applied in restoring or reestablishing corner:

D-3 1/4 Corner for Sections 5 and 8, T18N, R17W

ON September 16, 1995, I found a 3/4" Iron Rod, with M.C.R.C. cap, 0.3' North of steel fence post, 56.9', North of the center-line of Hansen Road, This location fit existing recorded witnesses, found no other evidence to dispute this location for the corner.

Condition of recorded witnesses is; #1 Gone #2 Gone #3 Road been moved #4 Road been moved
#5 Found in good cond. #6 Found in good cond. #7 OK #8 Found in good cond.

C. Description of monument for corner and accessories established to perpetuate locating the position of the corner:

D-3 1/4 Corner for Sections 5 and 8, T18N, R17W

I replace 3/4" Iron Rod with a 5/8" Re-Rod, 24" long, with an aluminum cap.(2 1/2" in dia.), Stamped MASON COUNTY MONUMENT, I placed monument flush with the ground, located on the North slope of bank, and is accepted as a careful and faithful reestablishment of the position of the original corner.

- OBT #5 Cedar 10" N 36° W 90.35'(60d spike in NE side of tree)
- OBT #6 Power Pole N 78° W 201.81'(60d spike in NE side of Pole)
- OBT #8 Guard Rail (south face) South 36.78'
Power Pole S 29° E 46.72'(60d spike in NE side of Pole)

Signed by Sammy S. Barnett

Surveyor's Michigan License No. 16923

Peer Group Reviewed and Approved

Date 9-28-95

Date: 9-28-95
Kenneth L. Ross
Mason County Surveyor

