

SURVEY & REMONUMENTATION

DEC 18 1995

COMMISSION

LAND CORNER RECORDATION CERTIFICATE
Filing Requirement of Act 74, Mich. P.A. 1970

For corners in

MASON
(County)

Located In:

Corner Code #

- | | | |
|------------------------------------|-------------------------|-------|
| 1. Public Land Survey | T 18 N R 17 W | E-2 |
| | T _____ R _____ | _____ |
| | T _____ R _____ | _____ |
| | T _____ R _____ | _____ |
| 2. Property Controlling in Section | S _____ T _____ R _____ | _____ |
| | S _____ T _____ R _____ | _____ |
| 3. Miscellaneous Property in Sec. | S _____ T _____ R _____ | _____ |
| | S _____ T _____ R _____ | _____ |

FILED
1970
AT 9:32 O'CLOCK ~ M
SEP 29 1995
MARY GOLDEN KOLASKI
MASON COUNTY
REGISTER OF DEEDS
Register of Deeds Stamp & File Number

4. Lot No. _____, Recorded Plat _____
5. Private Claims _____

A	B	C	D	E	F	G	H	I	J	K	L	M
2	6	5	4	3	2	1						
3												
4	7	8	9	10	11	12						
5												
6	18	17	16	15	14	13						
7												
8	19	20	21	22	23	24						
9												
10	30	29	28	27	26	25						
11												
12	31	32	33	34	35	36						
13												

I, Sammy S. Barnett, in a field survey on September 13, 1995, do hereby certify that under requirements of P.A. 74, Michigan P.A. of 1970, the corner points mentioned in lines 1 and 2 above were in conformance with regulations and rules therefore as required in the current manual of survey instructions of the United States Department of the Interior, Bureau of Land Management or by a decree of a Court of Law and/or that the corner points mentioned in lines 3, 4 and 5 above were in conformance with the rules of the Michigan Board of Land Surveyors or by a Decree of a Court of Law; established, re-established, monumented, re-monumented, recovered, found as expressed below:

NOTE: Not more than 4 corners, all in the same town and range, may be recorded on this certificate.

A. Description of original monument and accessories and/or subsequent restoration:

E-2 1/4 Corner for Section 4 and 5, T18N, R17W

1838. Sylvester Sibley, DS, G.L.O.

Identified as a stone with a cross

Set Wood Post

#1 Beech 5" N22W 181k.(11.88')

#2 Beech 4" S15°W 121k.(7.92')

1977, Ken Ross, MCS

Found Iron beside rock

#3 Maple 16" S25°E 70.60'

#4 Power Pole N29°W 68.25'

#5 Maple tw. 10" N60°W 48.00'

1979, Dennis Dunlap, RLS # 21759

monument not given

#7 Tw. Maple NW 48.06'

#8 Stump SW 41.00'

#9 maple 18' SE 70.60'

1883, C.E. Mitchell, MCS

Identified as a stake

1899, R.O. Towns, MCS

1984, Ken Ross, MCS

B. Description of corner evidence found and/or method applied in restoring or reestablishing corner: Raised "I" Iron w/ 1/2" Re-Rod

E-2 1/4 Corner for Sections 4 and 5, T18N, R17W

On September 13, 1995, I found a 1/2" Re-rod, 1.0 foot West of the center-line of Victory Drive (gravel) in line with old East-West fence line, I also found a "I" Iron below Re-rod, I also found an elonggated stone about a foot in lenght, with a cross chiesled in the top, next to and below "I" Iron. I found no other evidence to dispute this location for the 1/4 corner.

Condition of Record witnessess is;

- #1 Gone #2 Gone #3 Found in good cond. #4 Found in good cond. #5 Found in good cond.
#7 Same as 5 #8 Gone #9 Same as 3

C. Description of monument for corner and accessories established to perpetuate locating the position of the corner:

E-2 1/4 Corner for Sections 4 and 5, T18N, R17W

I replace 1/2" Re-rod with a 5/8" Re-rod, 24" long with an aluminum cap, 2 1/2" in dia., stamped MASON COUNTY MONUMENT, I placed Monument 0.5 feet below the gravel road, (I also removed the Stone and "I" Iron,) and is accepted as a careful and faithful reestablishment of the position of the original corner.


- OBT #3 Maple 28" S 25° E 70.60'(60d spike in NE side of tree)
OBT #4 Power Pole N 29° W 68.25'(16p nail w/ shiner in NE side of tree)
OBT # 5 Tw. Maple 18" N 60° W 48.37(60d spike in SW side of tree)
Red Pine 7" S 40° W 46.06'(60d spike in NE side of tree)

E-W) CREEK SOUTH 155'

Signed by Sammy S. Barnett Date 9-28-95

Surveyor's Michigan License No. 16923

Peer Group Reviewed and Approved
Date: 9-28-95
Kenneth L. Ross
Mason County Surveyor

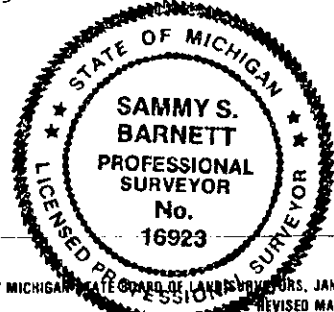

FORM APPROVED BY MICHIGAN STATE BOARD OF LAND SURVEYORS, JAN. 28, 1971
REVISED MAY 14, 1975
REVISED JAN., 1983