

DEC 18 1995


COMMISSION

LAND CORNER RECORDATION CERTIFICATE

Filing Requirement of Act 74, Mich. P.A. 1970

For corners in

MASON (County)	Located In:	Corner Code #
1. Public Land Survey	T 18 N R 17 W	E-3
	T R	
	T R	
	T R	
2. Property Controlling in Section	S T R	
	S T R	
3. Miscellaneous Property in Sec.	S T R	
	S T R	

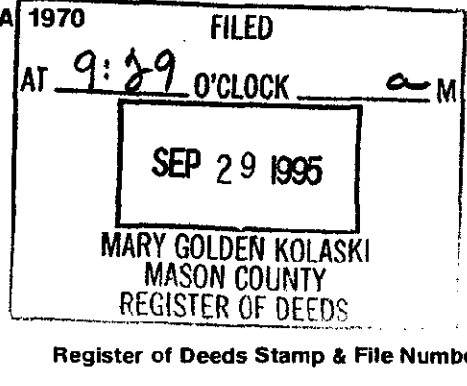

- 4. Lot No. \_\_\_\_\_, Recorded Plat \_\_\_\_\_
- 5. Private Claims \_\_\_\_\_

I, Sammy S. Barnett, in a field survey on September, 1995, do hereby certify that under requirements of P.A. 74, Michigan P.A. of 1970, the corner points mentioned in lines 1 and 2 above were in conformance with regulations and rules therefore as required in the current manual of survey instructions of the United States Department of the Interior, Bureau of Land Management or by a decree of a Court of Law and/or that the corner points mentioned in lines 3, 4 and 5 above were in conformance with the rules of the Michigan Board of Land Surveyors or by a Decree of a Court of Law; established, re-established, monumented, re-monumented, recovered, found as expressed below:

	A	B	C	D	E	F	G	H	I	J	K	L	M
2	6	5	4	3	2	1							
3													
4	7	8	9	10	11	12							
5													
6	18	17	16	15	14	13							
7													
8	19	20	21	22	23	24							
9													
10	30	29	28	27	26	25							
11													
12	31	32	33	34	35	36							
13													

**NOTE: Not more than 4 corners, all in the same town and range, may be recorded on this certificate.**

A. Description of original monument and accessories and/or subsequent restoration:

- E-3 Section Corner for Sections 4, 5, 8 and 9, T18N, R17W
- |   |  |   |
|---|--|---|
| 1838, Sylvester Sibley, DS, G.L.O.<br>Set Wood Post<br>#1 Beech 8" N34°E 331k.(21.78')<br>#2 Beech 8" S68°W 691k.(25.74') | 1968, M.C.R.C.<br>Identified as a stone and Iron<br>#3 Power Pole NE 89.19'<br>#4 T. Marker SE 29.81'<br>#5 Cherry 8" South 82.55' | 1978, Ken Ross, MCS<br>Identified as a PK nail over Iron<br>#6 Tele Box South 34.75'<br>#7 Stop Sign N25°W 48.59'<br>#8 Road Name Sign N50°E 48.90' |
| 1883, C.E. Mitchell, MCS<br>Stone<br>1966, Ken Stephens, MCS<br>Identified as an axil shaft                               |  |   |

B. Description of corner evidence found and/or method applied in restoring or reestablishing corner:

E-3 Section Corner for Sections 4, 5, 8 and 9, T18N, R17W

ON September 26, 1995, I found an Axil Shaft with gear, inside a road monument box, just South of the center-line of Hansen Road. This location fits existing record witnesses. I found no evidence to dispute this location for the corner.

Condition of recoded witnesses is; #1 Gone #2 Gone #3 Gone #4 Found a Tele-maker steel post @ 33.00'  
S 32° E #5 Found in good cond. #6 Found in good cond. #7 Sign as been replaced  
#8 Gone

C. Description of monument for corner and accessories established to perpetuate locating the position of the corner:

E-3 Section Corner for Sections 4, 5, 8 and 9, T18N, R17W

I replaced Axil Shaft with a 5/8" Re-rod, 24" long, with an aluminum cap(2 1/2" in dia.), stamped MASON COUNTY MONUMENT, I placed monument inside the existing road monument box, and is accepted as a careful and faithful reestablishment of the position of the original corner.

- DBT #5 Cherry 10" South 82.62'(60d spike in East side of tree)
- Power Pole S 68° E 94.75' (PK nail in SW side of pole)
- Power Pole N 66 E 73.40' (PK nail in SE side of pole)
- Power Pole S 68° W 57.75' ( PK nail in SE side of pole)

Signed by Sammy S. Barnett Peer Group Reviewed Date 9-28-95

Surveyor's Michigan License No. 16923

Date: 9-28-95  
Kenneth L. Ross  
Mason County Surveyor

