

DEC 18 1995


COMMISSION

LAND CORNER RECORDATION CERTIFICATE

Filing Requirement of Act 74, Mich. P.A. 1970

For corners in

MASON (County)	Located In:	Corner Code #
1. Public Land Survey	T 18 N R 17 W	G-1
	T _____ R _____	_____
	T _____ R _____	_____
	T _____ R _____	_____
2. Property Controlling in Section	S _____ T _____ R _____	_____
	S _____ T _____ R _____	_____
3. Miscellaneous Property in Sec.	S _____ T _____ R _____	_____
	S _____ T _____ R _____	_____

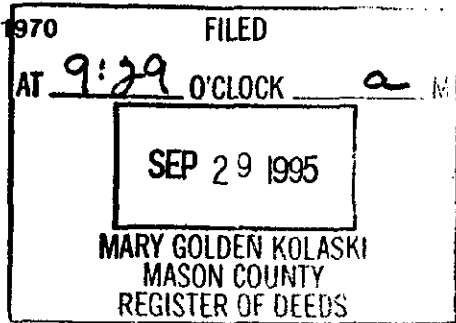

- 4. Lot No. _____, Recorded Plat _____
- 5. Private Claims _____

	A	B	C	D	E	F	G	H	I	J	K	L	M
2	6		5		4		3		2		1		
3													
4	7		8		9		10		11		12		
5													
6	18		17		16		15		14		13		
7													
8	19		20		21		22		23		24		
9													
10	30		29		28		27		26		25		
11													
12	31		32		33		34		35		36		
13													

I, Sammy S. Barnett, in a field survey on September 26, 1995, 1995, do hereby certify that under requirements of P.A. 74, Michigan P.A. of 1970, the corner points mentioned in lines 1 and 2 above were in conformance with regulations and rules therefore as required in the current manual of survey instructions of the United States Department of the Interior, Bureau of Land Management or by a decree of a Court of Law and/or that the corner points mentioned in lines 3, 4 and 5 above were in conformance with the rules of the Michigan Board of Land Surveyors or by a Decree of a Court of Law: established, re-established, monumented, re-monumented, recovered, found as expressed below:

NOTE: Not more than 4 corners, all in the same town and range, may be recorded on this certificate.

A. Description of original monument and accessories and/or subsequent restoration:

G-1 Section Corner for Sections 3 and 4, on the township line, T18N, R17W

- 1838, Sylvester Sibley, DS, G.L.O.
Set Wood Post (Set 26.40' East of corner for 33 & 34)
#1 S. Maple 10" S47°W 81k.(5.28')
#2 Beech 8" S85°E 161k(10.56')
- 1902, R.O. Towns, MCS
Identified as a brick & stake
- 1958, M.C.R.C.
Found Brick
#3 Elm 8" NW 114.80'
#4 Guy Power Pole SE 45'
#5 Brace Pole SW 51.5'
#6 Twin Elm NW 57.5'

- 1978, Ken Ross
Found 1/2" Iron Pipe
#7 17' East of center-line N-S Road
#8 Road Name sign, S70°W 51.68'
#9 Power Pole N65°E 51.13'
#10 Power Pole S 30° E 45.39'

B. Description of corner evidence found and/or method applied in restoring or reestablishing

G-1 Section Corner for Sections 3 and 4, on the township line, T18N, R17W

On September 26, 1995, I found a 1" I.D., Iron Pipe inside a road monument box, this location fits record witnesses that still exist, I found no other evidence to dispute this location for the corner.

- 1992, Ted Weinert, RLS
Replace 1" Iron Pipe with 1 1/2" x 24" Iron Pipe
#11 Fence Cor. N15°E 36.08'
#12 Power Pole N38°E 51.07'
#13 Power Pole S25°E 45.81'
#14 Poplar 4" N50°W 78.72'
SE Cor. Sec. 33, West 26.42'

Condition of recorded witnesses is; #1 Gone #2 Gone #3 gone #4 Gone #5 Gone #6 Gone
#7 Measured 21 feet #8 Sign as been replaced #9 Found in good cond. #10 Found in good cond.
#11 Gone #12 Gone #13 Same as 10 #14 Found in good cond.


C. Description of monument for corner and accessories established to perpetuate locating the position of the corner:

G-1 Section Corner for Sections 3 and 4, on the township line, T18N, R17W

I placed a 5/8" Re-rod, 24" long, with an aluminum cap(2 1/2" in dia.) stamped MASON COUNTY MONUMENT, inside the existing monument box, and is accepted as a careful and faithful reestablishment of the position of the original corner.

- OBT #9 Power Pole N 65° E 50.92'(60d spike in SE side of pole)
- OBT #10 Power Pole S 21° E 45.42'(Db. head nail w/ shiner in NE side of pole)
- OBT #14 Poplar 5" N 50° W 78.75'(60d spike in NE side of tree)
- Witness Iron(1/2" re-rod w/ rls cap #16923) N 45° E 21.50'

Signed by Sammy S. Barnett Peer Group Reviewed Date 9-28-95
Surveyor's Michigan License No. 16923 and Approved Date: 9-28-95

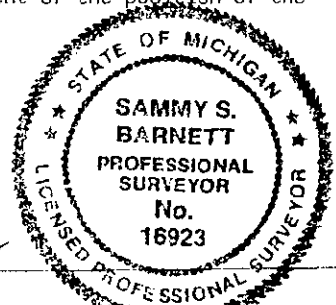

Kenneth L. Ross
Mason County Surveyor