


DEC 18 1995

COMMISSION

LAND CORNER RECORDATION CERTIFICATE
Filing Requirement of Act 74, Mich. P.A. 1970

For corners in

Table with columns: MASON (County), Located In: (Town, Range, Section), Corner Code #. Includes entries for Public Land Survey, Property Controlling in Section, and Miscellaneous Property in Sec.

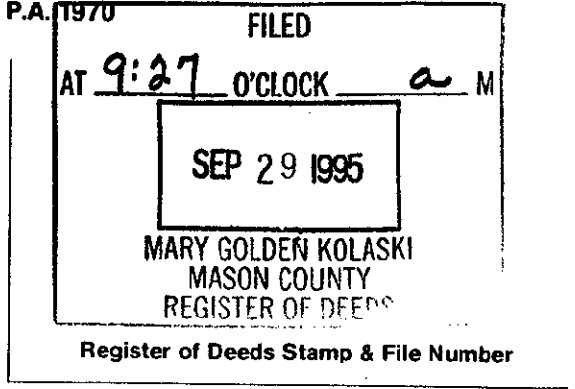

- 4. Lot No. , Recorded Plat
5. Private Claims

I, Sammy S. Barnett, in a field survey on September 15, 1995, do hereby certify that under requirements of P.A. 74, Michigan P.A. of 1970, the corner points mentioned in lines 1 and 2 above were in conformance with regulations and rules therefore as required in the current manual of survey instructions of the United States Department of the Interior, Bureau of Land Management or by a decree of a Court of Law and/or that the corner points mentioned in lines 3, 4 and 5 above were in conformance with the rules of the Michigan Board of Land Surveyors or by a Decree of a Court of Law; established, re-established, monumented, re-monumented, recovered, found as expressed below.

NOTE: Not more than 4 corners, all in the same town and range, may be recorded on this certificate.

A. Description of original monument and accessories and/or subsequent restoration:

H-3 1/4 Corner for Sections 3 and 10 T18N, R17W
1838, Sylvester Sibley, D.S., G.L.O. 1954 & 1955, Ken Stephens, MCS
Set Wood Posts Identified as 1" Sq. Iron
#1 Beech 12" N24°E 51k.(33.66') No witnesses
#2 Beech 8" N88°W 181k.(11.88') 1957, M.C.R.C.
Found 1" Iron Bar
#3 Power Pole NW 34'
#4 Fence Corner NE 46.5'
#5 Oak 20" SW 44.6'

#6 Maple Clump South 40.6'
1973 & 1974, Ken Ross, MCS
Found 1/2" Iron Pipe
#7 Maple 18" S10°E 41.75'
#8 Power Pole N25°W 33.51'
#9 W. Pine 8" S50°W 63.00'

Grid table with columns A-M and rows 2-13. A dot is marked at the intersection of column H and row 3.

B. Description of corner evidence found and/or method applied in restoring or reestablishing corner:

H-3 1/4 Corner for Sections 3 and 10, T18N, R17W

On September 15, 1995, I found a 1/2" Re-rod just below the surface of Hansen Road(asphalt) 1 foot North of the center-line, corner fit record witnesses, and found no other evidence to dispute this location for the corner.

Condition of recorded witnesses is; #1 Gone #2 Gone #3 Found in fair cond. #4 Gone #5 Gone #6 Found in good cond. #7 Same as 6 #8 Same as 3 #9 Found in good cond.

C. Description of monument for corner and accessories established to perpetuate locating the position of the corner:

H-3 1/4 corner for Sections 3 and 10, T18N, R17W

Replaced 1/2" Re-rod with a 5/8" Re-rod, 24" long, with an aluminum cap(2 1/2" in dia) stamped MASON COUNTY MONUMENT, placed inside a new road monument box, and is accepted as a careful and faithful reestablishment of the position of the original corner.

- OBT #7 Maple 20" S 10° E 41.75' (60d spike in East side of tree)
OBT #8 Power Pole N 25° W 33.51' (60d spike in NE side of Pole)
OBT #9 White Pine 14" S 50° W 62.80' (60d spike in NW side of tree)
White Pine 14" N 34° E 62.45' (60d spike in SE side of tree)

Signed by Sammy S. Barnett
Surveyor's Michigan License No. 16923

Peer Group Reviewed and Approved
Date:
Kenneth L. Ross
Mason County Surveyor

Date 9-28-95

