

SURVEY &
MONUMENTATION

DEC 18 1995

COMMISSION

LAND CORNER RECORDATION CERTIFICATE

Filing Requirement of Act 74, Mich. P.A. 1970

For corners in

MASON (County)	Located In:	Corner Code #
1. Public Land Survey	T 18 N R 17 W	I-1
	T _____ R _____	_____
	T _____ R _____	_____
	T _____ R _____	_____
2. Property Controlling in Section	S _____ T _____ R _____	_____
	S _____ T _____ R _____	_____
3. Miscellaneous Property in Sec.	S _____ T _____ R _____	_____
	S _____ T _____ R _____	_____

FILED

AT 3:37 O'CLOCK P M

SEP 15 1995

MARY GOLDEN KOLASKI
MASON COUNTY
REGISTER OF DEEDS

Register of Deeds Stamp & File Number

4. Lot No. _____, Recorded Plat _____
5. Private Claims _____

	A	B	C	D	E	F	G	H	I	J	K	L	M
2	6	5	4	3	2	1							
3													
4	7	8	9	10	11	12							
5													
6	18	17	16	15	14	13							
7													
8	19	20	21	22	23	24							
9													
10	30	29	28	27	26	25							
11													
12	31	32	33	34	35	36							
13													

I, Sammy S. Barnett, in a field survey on September 5, 1995, do hereby certify that under requirements of P.A. 74, Michigan P.A. of 1970, the corner points mentioned in lines 1 and 2 above were in conformance with regulations and rules therefore as required in the current manual of survey instructions of the United States Department of the Interior, Bureau of Land Management or by a decree of a Court of Law and/or that the corner points mentioned in lines 3, 4 and 5 above were in conformance with the rules of the Michigan Board of Land Surveyors or by a Decree of a Court of Law; established, re-established, monumented, re-monumented, recovered, found as expressed below:

NOTE: Not more than 4 corners, all in the same town and range, may be recorded on this certificate.

A. Description of original monument and accessories and/or subsequent restoration:

I-1 Section Corner for Sections 2 and 3, on the township line, T18N, R17W

1838, Sylvester Sibley, DS, G.L.O.
Set Wood Post, 24 lk.(15.84' East of Post for Sec. 34 & 35, T19N, R17W
#1 Beech 14" S 81°E 13 lk.(8.58')
#2 Hemlock 10" S 77°W 11 lk.(7.26')

1985, Dennis dunlap, RLS 21759
Found 1 1/2" Iron Pipe, by K. Ross (L245, Pg.296
Iron Pipe was Bent, replaced with a RLS Cap Re-Rod
No Witnesses taken
1974, Ken Ross, M.C.S.
Set 1" Iron Pipe, Used East Line of the Plat of Crystal Heights(1967) for East-West controll and old fence line for North-South controll (over)

B. Description of corner evidence found and/or method applied in restoring or reestablishing corner:

I-1 Section Corner for Sections 2 and 3, On the township line, T18N, R17W.

On September 5, 1995 I, found a 1/2" Re-rod with RLS cap # 21759, Dennis Dunlap, I found ^{THE} Re-rod 3 feet East of the center-line of Amber Road(gravel), I also found RLS cap Re-rod 16.95 feet East(Ross), I feel this Re-rod is for East R.O.W. ^{of No. 14} Section 35, T19N, R17W, it measured 32.76 feet from SW Corner for Section 35. I search area for other Irons or Markers or any other evidence, but found nothing to dispute this location.

Condition of Recorded Witnesses is: #1 Gone #2 Gone #3 Found in good cond. #4 Found in good cond. #5 Found in good cond.

C. Description of monument for corner and accessories established to perpetuate locating the position of the corner:

-1 Section Corner for Sections 2 and 3, on the township line, T18N, R17W.


I replaced 1/2" Re-rod with a 5/8" Re-rod, 24" long with an aluminum cap, stamped MASON COUNTY MONUMENT I placed the Monument 0.5 of a foot below the gravel road, and is accepted as a careful and faithful reestablishment of the position of the original corner.

- OBT #3 Red Oak 36" N 40° W 33.21'(60d spike in SW side of tree)
- OBT #4 S. Maple 17" N 35° E 31.90'(60d spike in NW side of tree)
- OBT #5 Cherry 20" N 85° E 18.13'(60d spike in NW side of tree)
- Red Oak 10" S 71° E 22.61'(60d spike in NE side of tree)

Signed by Sammy S. Barnett Date 9-8-95

Surveyor's Michigan License No. 16923

Peer Group Reviewed and Approved
Date: 7-12-95
Kenneth L. Ross
Mason County Surveyor

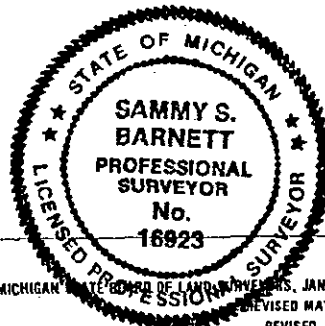

FORM APPROVED BY MICHIGAN BOARD OF LAND SURVEYORS, JAN. 28, 1971
REVISED MAY 14, 1975
REVISED JAN., 1983

I-1 Section Corner for Section 2 and 3, T18N, R17W,

(cont.)

#3	Red Oak	30"	N 40° W	33.21'
#4	Maple	16"	N 35° E	31.90'
#5	Cherry	20"	N 85° E	18.13'