

**SURVEY &
REMONUMENTATION**


DEC 18 1995

COMMISSION LAND CORNER RECORDATION CERTIFICATE

Filing Requirement of Act 74, Mich. P.A. 1970

For corners in

<u>MASON</u> (County)	Located In:	Corner Code #
1. Public Land Survey	T <u>18 N</u> R <u>17 W</u>	<u>I-2</u>
	T _____ R _____	_____
	T _____ R _____	_____
	T _____ R _____	_____
2. Property Controlling in Section	S _____ T _____ R _____	_____
	S _____ T _____ R _____	_____
3. Miscellaneous Property in Sec.	S _____ T _____ R _____	_____
	S _____ T _____ R _____	_____

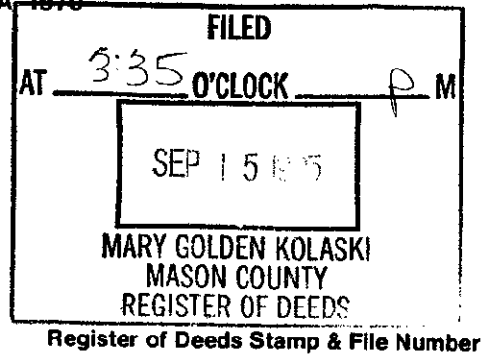

4. Lot No. _____, Recorded Plat _____
5. Private Claims _____

	A	B	C	D	E	F	G	H	I	J	K	L	M
2	6	5	4	3	2	1							
3													
4	7	8	9	10	11	12							
5													
6	18	17	16	15	14	13							
7													
8	19	20	21	22	23	24							
9													
10	30	29	28	27	26	25							
11													
12	31	32	33	34	35	36							
13													

I, Sammy S. Barnett, in a field survey on August 31, 19 95, do hereby certify that under requirements of P.A. 74, Michigan P.A. of 1970, the corner points mentioned in lines 1 and 2 above were in conformance with regulations and rules therefore as required in the current manual of survey instructions of the United States Department of the Interior, Bureau of Land Management or by a decree of a Court of Law and/or that the corner points mentioned in lines 3, 4 and 5 above were in conformance with the rules of the Michigan Board of Land Surveyors or by a Decree of a Court of Law; established, re-established, monumented, re-monumented, recovered, found as expressed below:

NOTE: Not more than 4 corners, all in the same town and range, may be recorded on this certificate.

A. Description of original monument and accessories and/or subsequent restoration:

I-2 1/4 Corner for Sections 2 and 3, T18N, R17W

1838, Sylvester Sibley, DS, G.L.O.

Set Wood Post

#1 Beech 12" S43°W 26 lk.(17.16')

#2 Beech 10" S68°E 37 lk.(24.42')

1899, R.O. Towns, MCS

Monument not given

1980, Ken Ross, MCS

Found 2" Pipe, Set 1/2" Re-Rod

#3 Beech 8" N80°E 30.68'

#4 Red Pine 16" North, 50.10'

#5 White Pine 20" S 10°W 48.97'

Undated survey, Corner Record # C-17

Wagon skien Iron

B. Description of corner evidence found and/or method applied in restoring or reestablishing corner:

I-2 1/4 Corner for Sections 2 and 3, T18N, R17W

On August 31, 1995, I found a 1/2" Re-rod, that fit Ken Ross's recorded witness, also found a RSL cap Re-rod 2.55 feet North, for a ~~corner~~, found no other evidence to dispute this location for the corner. **PARCEL COR. ROSS SURVEY Q777**

Condition of Recorded Witnesses is; #1 Gone #2 Gone #3 Found in good cond. #4 Gone #5 Gone

C. Description of monument for corner and accessories established to perpetuate locating the position of the corner:


I-2 1/4 corner for Sections 2 and 3, T18N, R17W

I replaced 1/2" Re-rod with a 5/8" Re-rod, 24" long, with an aluminum cap (2 1/2" in dia.), stamped MASON COUNTY MONUMENT, the corner is place at the intersection of old fences North-South and East, and is accepted as a careful and faithful reestablishment of the position of the original corner.

- DBT #3 Beech 12" N 80° E 30.50'(60d spike in SE side of tree)
- NE corner of Cabin (1613 Crystal View) N 52° W 68.10'
- Power Pole N 25° E 3.43'(60d spike in SE side of Pole)
- S. Maple 6" S 34° E 15.32'(60d spike in SW side of tree)
- RLS Capped Re-rod North, 2.55'

Signed by Sammy S. Barnett Date 9-8-95

Surveyor's Michigan License No. 16923 Date: 9-12-95

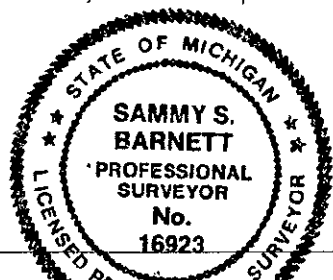

LIBER 3 PAGE 289
Kenneth L. Ross
Mason County Surveyor