


DEC 18 1995

COMMISSION

LAND CORNER RECORDATION CERTIFICATE
Filing Requirement of Act 74, Mich. P.A. 1970

For corners in

<u>MASON</u> (County)	Located in:	Corner Code #:
1. Public Land Survey	T <u>18 N</u> R <u>17W</u>	<u>I-3</u>
	T _____ R _____	_____
	T _____ R _____	_____
	T _____ R _____	_____
2. Property Controlling in Section	S _____ T _____ R _____	_____
	S _____ T _____ R _____	_____
3. Miscellaneous	S _____ T _____ R _____	_____
Property in Sec.	S _____ T _____ R _____	_____
4. Lot No. _____, Recorded Plat _____		
5. Private Claims _____		

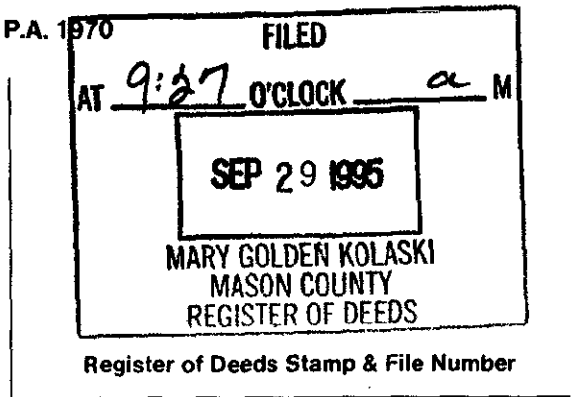

I, Sammy S. Barnett, in a field survey on September 15, 1995, do hereby certify that under requirements of P.A. 74, Michigan P.A. of 1970, the corner points mentioned in lines 1 and 2 above were in conformance with regulations and rules therefore as required in the current manual of survey instructions of the United States Department of the Interior, Bureau of Land Management or by a decree of a Court of Law and/or that the corner points mentioned in lines 3, 4 and 5 above were in conformance with the rules of the Michigan Board of Land Surveyors or by a Decree of a Court of Law; established, re-established, monumented, re-monumented, recovered, found as expressed below:

A	B	C	D	E	F	G	H	I	J	K	L	M
2	6	5	4	3	2							
3								●				
4	7	8	9	10	11	12						
5												
6	18	17	16	15	14	13						
7												
8	19	20	21	22	23	24						
9												
10	30	29	28	27	26	25						
11												
12	31	32	33	34	35	36						
13												

NOTE: Not more than 4 corners, all in the same town and range, may be recorded on this certificate.

A. Description of original monument and accessories and/or subsequent restoration:
 I-3 Section Corner for Sections 2, 3, 10 and 11, T18N, R17W

1838, Sylvester Sibley, D.S., G.L.O.
 Set Wood Post
 #1 Beech 20" N54°E 221k.(14.52')
 #2 Beech 10" S33°W 291k.(18.48')

1954 & 1956, Ken Stephens, MCS
 Identified as a 1" Iron
 no witnesses

1973, Ken Ross, MCS
 1½" Iron Pipe
 #5 Conc. Mon. N40°W 56.44'
 #6 Conc. Mon. N40°E 57.03'
 #7 Road Name sign S50°W 39.42'

1899, R.O. Towns, MCS
 Identified corner as a stone
 no witnesses

1957, M.C.R.C.
 Found Iron 6" below Road surface
 #3 Ash 24" North 31.60'
 #4 Power Pole NW 81.00'

B. Description of corner evidence found and/or method applied in restoring or reestablishing corner:

I-3 Section Corner for Sections 2, 3, 10 and 11, T18N, R17W

On September 15, 1995, I found a 1½" Iron Pipe inside a road monument box, 4 feet South of the center-line of Hansen Road(asphalt), this location fit the recorded witnesses, and found no other evidence to dispute this location for the corner.


Condition of recorded witnesses is; #1 Gone #2 Gone #3 gone #4 Found in good cond. #5 Found in good cond. #6 Gone #7 Gone

C. Description of monument for corner and accessories established to perpetuate locating the position of the corner:

I-3 Section Corner for Sections 2, 3, 10 and 11, T18N, R17W.

I replaced 1½" Iron Pipe with a 5/8" Re-rod, 24" long, with an aluminum cap(2½" in dia.), stamped MASON COUNTY COUNTY MONUMENT, I place monument in existing monument box, and is accepted as a careful and faithful reestablishment of the position of the original corner.

OBT #4 Power Pole N 20° W 81.00'(60d spike, flush in NE side of power pole)
 Power Pole N 22° E 80.30'(PK nail in NW side of pole)
 Power Pole S 21° E 57.81'(PK Nail in NE side of pole)
 NE corner of Garage foundation S 27° W 134.35'

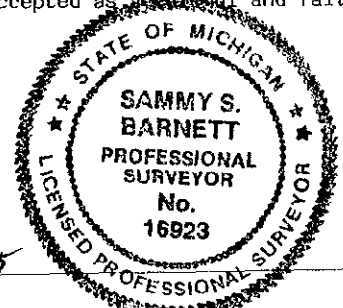

Signed by Sammy S. Barnett
 Surveyor's Michigan License No. 16923

Peer Group Reviewed and Approved
 Date: 9-28-95
Kenneth L. Ross
 Mason County Surveyor