


SURVEY & REMONUMENTATION

MAY 07 1997

LAND CORNER RECORDATION CERTIFICATE
Filing Requirement of Act 74, Mich. P.A. 1970

For corners in **COMMISSION**

Mason (County)	Located In:	Corner Code #
1. Public Land Survey	T <u>18N</u> R <u>17W</u>	I - 07
	T <u> </u> R <u> </u>	_____
	T <u> </u> R <u> </u>	_____
	T <u> </u> R <u> </u>	_____
2. Property Controlling In Section	S <u> </u> T <u> </u> R <u> </u>	_____
	S <u> </u> T <u> </u> R <u> </u>	_____
3. Miscellaneous Property in Sec.	S <u> </u> T <u> </u> R <u> </u>	_____
	S <u> </u> T <u> </u> R <u> </u>	_____

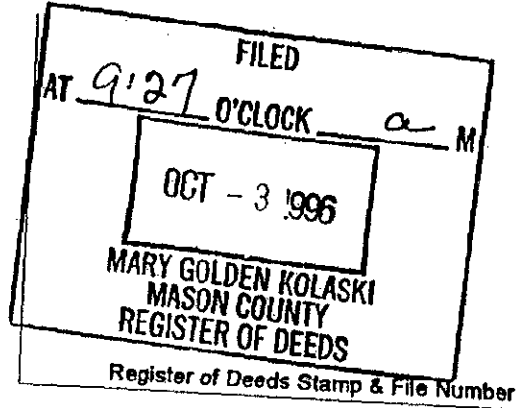

4. Lot No. _____, Recorded Plat _____
5. Private Claims _____

I, Sammy S. Barnett, in a field survey on Sept, 1996 do hereby state that under requirements of P.A. 74, Michigan P.A. of 1970, the corner points mentioned in lines 1 and 2 above were in conformance with regulations and rules therefore as required in the current manual of survey instructions of the United States Department of the Interior, Bureau of Land Management or by a decree of a Court of Law and for that the corner points mentioned in lines 3, 4 and 5 above were in conformance with the rules of the Michigan Board of Land Surveyors or by a Decree of a Court of Law; established, re-established, monumented, recovered, found as expressed below:

NOTE: Not more than 2 corners, all in the same town and range, may be recorded on this certificate.

	A	B	C	D	E	F	G	H	I	J	K	L	M
1													
2	6		5			4			3		2		1
3													
4	7		8			9			10		11		12
5													
6	18		17			16			15		14		13
7													
8	19		20			21			22		23		24
9													
10	30		29			28			27		26		25
11													
12	31		32			33			34		35		36
13													

A. Description of original monument and accessories and/or subsequent restoration:

1-07 Corner common to Sections 14,15,22 & 23 T18N, R17W Amber
1838 Syl. Sibley G.L.O.
Set Post
#1 Beech 20" N1E 36 lks (23.76')
#2 Beech 20" S40W 8 lks. (5.28')
1911 R.O. Towns Co. Surveyor
Blue Stone no witnesses
1960 K.B. Stephens Co. Surveyor
Existing pipe, no witnesses

1964 Co. Rd. Comm.
1 1/2" pipe & Blue stone
#3 Maple 12" S.E. 69.6'
#4 Twin Elm 6" N.W. 79.3'
#5 Power Pole S.W. 61.8'
1966 K.B. Stephens
Found 1 1/2" Pipe & Blue Stone
#6 Twin Elm 6" N.W. 79.3 (#4)

#7 Maple 12" S.E. 69.6" (#3)
#8 Power Pole S.W. 62.10" (#5)
1972 J. Borsfay MCRC
Found 1 1/2" pipe 8" below surface
#9 Tel. Pole N.E. 62.24'
#10 Maple 24" S.E. 70.35' Spike (#3 & 7)
#11 Power Pole S.W. 62.10' (#8)
1974 Barry G. Krebs BLM
Found 1 1/2" pipe 8" below surface
No new witnesses

(over)

B. Description of corner evidence found and/or method applied in restoring or reestablishing corner:

1-07 Corner common to Sections 14,15,22 & 23 T18N, R17W Amber
On Sept. 6, I found 1 1/2" pipe in monument box. I found no evidence to dispute
The condition of the recorded witnesses are;

- # 1 Gone
- # 2 Gone
- # 3 Stump
- # 4 Gone
- # 5 Gone. New pole
- # 6 Same as # 4
- # 7 Same as # 3
- # 8 Same as # 5
- # 9 Gone
- # 10 Stump
- # 11 Gone. New pole
- # 12 Same as # 3, 7 & 10
- # 13 Same as # 9
- # 14 Rd. name sign S50W 43.15'
- # 15 Stump same as # 3, 7, 10 & 12

- # 16 Stump same as # 9
- # 17 Gone same as # 5 & 8
- # 18 Power pole S25E 70.59'


this location.

C. Description of monument for corner and accessories established to perpetuate locating the position of the corner:

1-07 Corner common to Sections 14,15,22 & 23 T18N, R17W Amber
I set Standard Mason County Monument inside of existing 1 1/2" pipe and accepted this location as a careful and faithful reestablishment of the position of the original corner.
19 Power pole S48W 59.03' spike in SE side
20 Maple 12" S75E 94.75' Spike in NE side
21 Power pole # 61 S25E 70.50' PK with shiner in SW side
22 Elm 10" N06W 134.58' Spike in E. side

Signed by Sammy S. Barnett
Surveyor's Michigan License No. 16923

Date 9-24-96

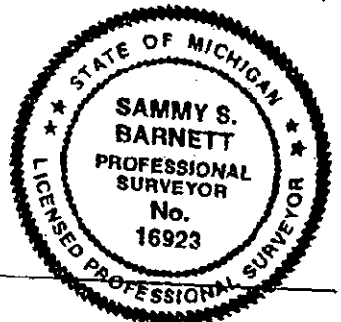

Peer Group Reviewed and Approved
Date: 10-30-96
Kenneth L. Ross
Mason County Surveyor

I 07 Corner common to Sections 14,15,22 & 23 T18N, R17W Amber

1974 K. Ross Act 74 L 1 P 264

Ex. 1 $\frac{1}{4}$ " pipe

#12 Maple 24" S70W 69.21' (#3, 7 & 10)

#13 Tel. Pole N65E 62.11' (#9)

#14 Rd. name sign S50W 43.15'

1984 L. Slater M.D.O.T.

Found $\frac{1}{2}$ " iron bar in 1" ID Galv. Pipe.

3" West of Ex. C/L Amber Rd. & on EX C/L of first St.

#15 27" Stump S60W 69.32' (#3,7,10 & 12)

#16 Tel Pole N70E 62.21' (#9 & 13)

#17 P.P. S55W 62.08" (# 5 & 8)

#18 P.P. S25E 70.59'