

**SURVEY & REMONUMENTATION**


MAY 07 1997

COMMISSION

**LAND CORNER RECORDATION CERTIFICATE**  
Filing Requirement of Act 74, Mich. P.A. 1970

For corners in

Mason (County)	Located In:	Corner Code #
1. Public Land Survey	T 18N R 17W	1-09
	T R	
	T R	
	T R	
2. Property Controlling in Section	S T R	
	S T R	
3. Miscellaneous Property in Sec.	S T R	
	S T R	

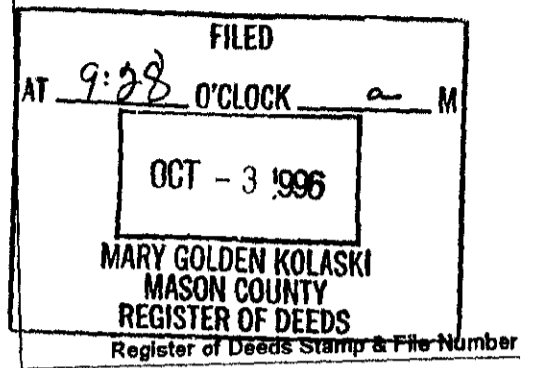

4. Lot No. \_\_\_\_\_, Recorded Plat \_\_\_\_\_  
5. Private Claims \_\_\_\_\_

I, Sammy S. Barnett, in a field survey on Sept., 1996 do hereby state that under requirements of P.A. 74, Michigan P.A. of 1970, the corner points mentioned in lines 1 and 2 above were in conformance with regulations and rules therefore as required in the current manual of survey instructions of the United States Department of the Interior, Bureau of Land Management or by a decree of a Court of Law and for that the corner points mentioned in lines 3, 4 and 5 above were in conformance with the rules of the Michigan Board of Land Surveyors or by a Decree of a Court of Law; established, re-established, monumented, recovered, found as expressed below:

NOTE: Not more than 2 corners, all in the same town and range, may be recorded on this certificate.

	A	B	C	D	E	F	G	H	I	J	K	L
1												
2	6	5	4	3	2	1						
3												
4	7	8	9	10	11	12						
5												
6	18	17	16	15	14	13						
7												
8	19	20	21	22	23	24						
9												
10	30	29	28	27	26	25						
11												
12	31	32	33	34	35	36						
13												

**A. Description of original monument and accessories and/or subsequent restoration:**

- 1-09 Corner common to sections 22,23,26 & 27, T18N, R17W, (Amber)
- 1838 Syl. Sibley G.L.O.
- Set post
- #1 Beech 14" S80W 29 lks. (19.14')
- #2 Sugar 12" N03E 36 lks. (23.76')
- 1958 M.C.R.C.
- Found 1" pipe, 1/2" rod & Stones
- #3 Butternut 6" N.E. 70.0'
- #4 Maple 6" N.E. 67.4'
- #5 Elm 18" S.E. 41.1'
- #6 Maple 30" S. 46.0'
- 1972 J. Borsfay
- Found 1/2" rod in 1" pipe
- #7 Maple 30" S. 46.01' spike (#6)
- #8 W. Cherry 18" S.E. 51.42' spike
- #9 Maple 6" N.W. 47.84 spike
- #10 Maple 10" N.E. 67.52 spike (#4)
- 1974 Barry G. Krebs B.L.M.
- Found 1" pipe, No new witnesses
- 1978 G. Bonney Act 74 L 2, P. 67
- Found 1/2" iron P.K. on top
- #11 Maple 34" S. 46.01' (#6 & 7)
- #12 Cherry 20" S20E 51.42' (#8)
- #13 Maple 10" N40W 47.84' (#9)
- #14 Maple 14" N45E 67.52' (#4 & 10)
- 1991 K. Ross
- Found 5/8" ir. in mon. box

**B. Description of corner evidence found and/or method applied in restoring or reestablishing corner:**

1-09 Corner common to sections 22,23,26 & 27, T18N, R17W, (Amber)  
On Sept. 5th I found 5/8" iron in monument box, I found no evidence to disput this location. Condition of recorded witnesses are;

- # 1 Gone
- # 2 Gone
- # 3 Gone
- # 4 Maple 20" N43E 67.75' added spike in NW side
- # 5 gone
- # 6 Maple 32" S02E 45.96' added spike in W. side
- # 7 Same as # 6
- # 8 W. Cherry 24" S19E 53.80' added spike in SW side
- # 9 found dying
- # 10 Same as # 4
- # 11 Same as # 6 & # 7
- # 12 Same as # 8
- # 13 Same as # 9
- # 14 Same as # 4 & # 10


**C. Description of monument for corner and accessories established to perpetuate locating the position of the corner:**

1-09 Corner common to sections 22,23,26 & 27, T18N, R17W, (Amber)  
I replaced the 5/8" iron, in the exact location. with a Standard Mason County Monument. in the existing monument box. and is accepted as a careful and faithful reestablishment of the position of the original corner.

- # 4 Maple 20" N43E 67.75' spike in NW side
- # 6 Maple 32" S02E 45.96' spike in W. side
- # 8 W. Cherry 24" S19E 53.80' spike in SW side
- # 15 Ash 19" S75W 72.41' spike in NW side

Signed by Sammy S. Barnett  
Surveyor's Michigan License No. 16923

Date 9-24-96

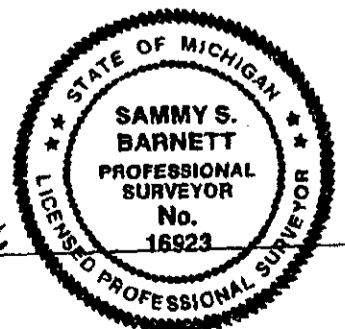

Peer Group Reviewed and Approved  
Date: 9-30-96  
Kenneth L. Ross  
Mason County Surveyor