

**SURVEY &
REMONUMENTATION**

JAN 23 2001


SECTION

LAND CORNER RECORDATION CERTIFICATE

Filing Requirement of Act 74, Mich. P.A. 1970

For corners In: Located In: Corner Code #
Mason County

- | | | |
|------------------------------------|-------------------------|-------|
| 1. Public Land Survey | T 18N R 17W | J-3 |
| | T _____ R _____ | _____ |
| | T _____ R _____ | _____ |
| | T _____ R _____ | _____ |
| 2. Property Controlling in Section | S _____ T _____ R _____ | _____ |
| | S _____ T _____ R _____ | _____ |
| 3. Miscellaneous Property in Sec. | S _____ T _____ R _____ | _____ |
| | S _____ T _____ R _____ | _____ |

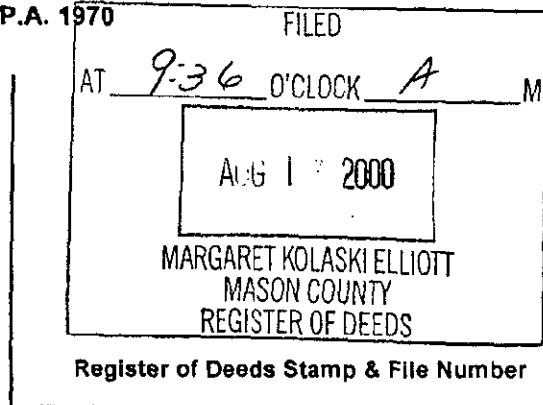

4. Lot No. _____, Recorded Plat _____
5. Private Claims _____

	A	B	C	D	E	F	G	H	I	J	K	L	M
1													
2	6	5	4	3	2	1							
3													
4	7	8	9	10	11	12							
5													
6	18	17	16	15	14	13							
7													
8	19	20	21	22	23	24							
9													
10	30	29	28	27	26	25							
11													
12	31	32	33	34	35	36							
13													

I, Kenneth L. Ross in a field survey on June 8, 2000, Do hereby certify that under requirements of P.A. 74, Michigan P.A. of 1970, the corner points mentioned in lines 1 and 2 above were in conformance with regulations and rules therefore as required in the current manual of survey instructions of the United States Department of the Interior, Bureau of Land Management or by a decree of a Court of Law and/or that the corner points mentioned in lines 3, 4 and 5 above were in conformance with the rules of the Michigan Board of Land Surveyors or by a Decree of a Court of Law; established, re-established, monumented, re-monumented, recovered, found as expressed below:

¼ corner common to sections 2 and 11 of T18N., R17W.

A. Description of original monument and accessories and/or subsequent restoration:

- | | |
|---|--|
| GLO 1839 Sibley set qr. sec. post
Beech 10" N38E 15 lks. (9.90') #1
Beech 8" S61W 9 lks. (5.94') #2 | Ross PLS 17634 unrecorded 1995
iron in mon. box |
| Stephens RLS 7318 Unrecorded 1960
Ex. iron at N ¼ cor.
No witnesses shown | Stephens RLS 7318 unrecorded 1956
Ex. stone marked by ½" pipe
No witnesses taken |
| Stephens RLS 17634 Unrecorded 1968
Fd. ¼" pipe
PP N48E 49.99' #3
Stop sign N12W 52.58' #4
Rd. name sign S45W 37.22' #5
PP S26W 42.56' #6 | MCRC 1957
PP NE 50.0' #3
18" Elm SSW 52.5' #4
24" Elm WSW 87.0' #7
Rd. Sign SW 37.12' #5 |

B. Description of corner evidence found and/or method applied in restoring or reestablishing corner:


I found a 50d spike riser in the center of a N-S rd. and 0.5' S. of the centerline of and E-W rd. for a ¼" pipe of undetermined length in a monument box.
Condition of accessories: 1, 2, 4, 5, 6, and 7 are gone, 3 is in good condition.
I found nothing to dispute the location of this corner

C. Description of monument for corner and accessories established to perpetuate locating the position of the corner:

I drove a 5/8" X 18" iron rod over the existing ¼" pipe and set a 2 ½" Aluminum cap stamped "Mason County Monument, PLS 17634" on the 5/8" iron in the monument box and accepted this as a careful and faithful reestablishment of the position of the original corner.

- P Pole S31E 65.60' (Ex. 16d nail in E side)
- P Pole S50W 50.49' (Set mag nail on NW side)
- P Pole N49E 49.90' (MSHD nail & shiner on NW side) #3
- P Pole N83E 189.36' (Set mag nail S side)

Signed by [Signature] Date 8-10-2000
Surveyor's Michigan License No. 17634

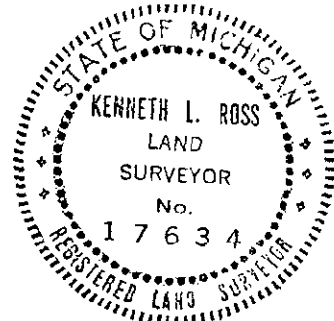

FORM APPROVED BY MICHIGAN STATE BOARD OF LAND SURVEYORS, JAN. 28,

1971
REVISED MAY 14, 1975
REVISED JAN., 1983
ADAPTED FOR WORD PROCESSING MARCH, 1983

Approved by Peer Review Group on 8-10-2000
Kenneth L. Ross, County Representative [Signature]