


SURVEY & REMONUMENTATION

MAY 07 1997

LAND CORNER RECORDATION CERTIFICATE
Filing Requirement of Act 74, Mich. P.A. 1970

For corners in **COMMISSION**

Mason (County)	Located In:	Corner Code #
1. Public Land Survey	T 18N R 17W	J-09
	T R	
	T R	
	T R	
2. Property Controlling in Section	S T R	
	S T R	
3. Miscellaneous Property in Sec.	S T R	
	S T R	

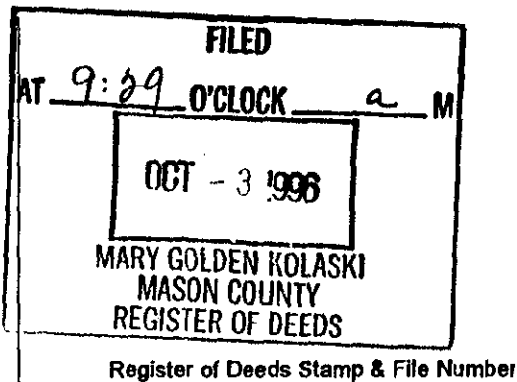

4. Lot No. _____, Recorded Plat _____
5. Private Claims _____

I, Sammy S. Barnett, in a field survey on Sept. 5, 1996 do hereby state that under requirements of P.A. 74, Michigan P.A. of 1970, the corner points mentioned in lines 1 and 2 above were in conformance with regulations and rules therefore as required in the current manual of survey instructions of the United States Department of the Interior, Bureau of Land Management or by a decree of a Court of Law and/or that the corner points mentioned in lines 3, 4 and 5 above were in conformance with the rules of the Michigan Board of Land Surveyors or by a Decree of a Court of Law; established, re-established, monumented, recovered, found as expressed below:

NOTE: Not more than 2 corners, all in the same town and range, may be recorded on this certificate.

	A	B	C	D	E	F	G	H	I	J	K	L
1												
2	6		5		4		3		2		1	
3												
4	7		8		9		10		11		12	
5												
6	18		17		16		15		14		13	
7												
8	19		20		21		22		23		24	
9												
10	30		29		28		27		26		25	
11												
12	31		32		33		34		35		36	
13												

A. Description of original monument and accessories and/or subsequent restoration:

J-09 1/4 corner common to sections 23 & 26, T18N, R17W, (Amber)
1838 Syl Sibley G.L.O. 1972 J. Borsfay
Set post Found 1 1/2" pipe
#1 Beech 14" N43E 32 lks. (21.12") #6 Maple 30" S70-45W 56.68' spike (#5)
#2 Beech 8" S30W 20 lks. (13.2') #7 Maple 36" S70E 32.61' spike
Undated M.C.R.C 1974 Barry G. Krebs B.L.M.
Iron Stake Found 1 1/2" Pipe 6" below surface
#3 Maple 18" N17 1/2 E 97.4' No witnesses taken
#4 Maple 20" N.W. 31.4 (gone)

1988 K. Ross Act 132 L. 372, P. 770
Found 1" pipe at Rd. P.I.
#8 R. Pine 12" N33E 53.95'
#9 Maple 36" S72E 32.60' (#7)
#10 Maple 28" S85W 154.32'

B. Description of corner evidence found and/or method applied in restoring or reestablishing corner:

J-09 1/4 corner common to sections 23 & 26, T18N, R17W, (Amber)
On Sept 5, I found 1 1/2" iron 0.5' below ground at the extended centerline of gravel roads N. & W.. old fence line E. I found no evidence to dispute this location. Condition of recorded witnesses are;

- # 1 Gone
- # 2 Gone
- # 3 Found stump 8' high
- # 4 Gone
- # 5 Maple 34" S70W 56.70' spike in SE side
- # 6 Same as # 5
- # 7 Maple 48" S70E 32.63' Spike in SW side
- # 8 R. Pine 12" N33E 53.98' Spike in NW side
- # 9 Same as # 7
- # 10 Maple 28" S85W 154.32' spike in N. side


C. Description of monument for corner and accessories established to perpetuate locating the position of the corner:

J-09 1/4 corner common to sections 23 & 26, T18N, R17W, (Amber)
I replaced the 1 1/2" Iron, in the exact location, with a Standard Mason County Monument at the surface of the ground, and accepted this location as a careful and faithful reestablishment of the position of the original corner

- # 5 Maple 34" S70W 56.70' spike in SE side
- # 7 Maple 48" S70E 32.63' spike in SW side
- # 8 R. Pine 12" N33E 53.98' spike in NW side
- # 10 Maple 28" S85W 154.32' spike in N. side

Signed by Sammy S. Barnett
Surveyor's Michigan License No. 16923

Date 9-24-96

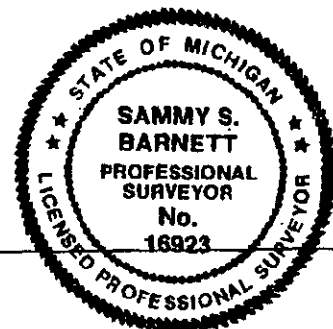

Peer Group Reviewed and Approved
Date: 9-30-96
Kenneth E. Ross
Mason County Surveyor