

SURVEY & REMONUMENTATION


DEC 18 1995

COMMISSION LAND CORNER RECORDATION CERTIFICATE

Filing Requirement of Act 74, Mich. P.A. 1970

For corners in

<u>MASON</u> (County)	Located In:	Corner Code #
1. Public Land Survey	T <u>18 N</u> R <u>17 W</u>	<u>K-1</u>
	T _____ R _____	_____
	T _____ R _____	_____
	T _____ R _____	_____
2. Property Controlling in Section	S _____ T _____ R _____	_____
	S _____ T _____ R _____	_____
3. Miscellaneous Property in Sec.	S _____ T _____ R _____	_____
	S _____ T _____ R _____	_____
4. Lot No. _____, Recorded Plat _____		
5. Private Claims _____		

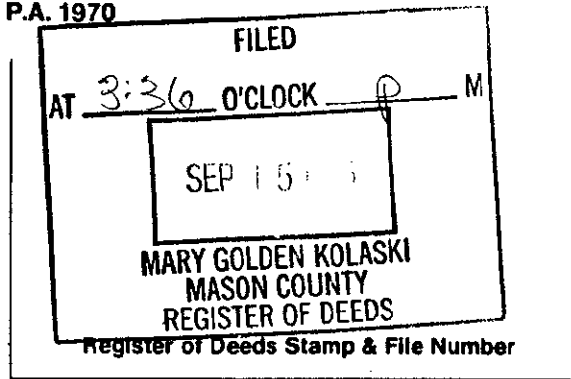

	A	B	C	D	E	F	G	H	I	J	K	L	M
2	6		5		4		3		2		1		
3													
4	7		8		9		10		11		12		
5													
6	18		17		16		15		14		13		
7													
8	19		20		21		22		23		24		
9													
10	30		29		28		27		26		25		
11													
12	31		32		33		34		35		36		
13													

I, Sammy S. Barnett, in a field survey on August 31, 1995, do hereby certify that under requirements of P.A. 74, Michigan P.A. of 1970, the corner points mentioned in lines 1 and 2 above were in conformance with regulations and rules therefore as required in the current manual of survey instructions of the United States Department of the Interior, Bureau of Land Management or by a decree of a Court of Law and/or that the corner points mentioned in lines 3, 4 and 5 above were in conformance with the rules of the Michigan Board of Land Surveyors or by a Decree of a Court of Law; established, re-established, monumented, re-monumented, recovered, found as expressed below:

NOTE: Not more than 4 corners, all in the same town and range, may be recorded on this certificate.

A. Description of original monument and accessories and/or subsequent restoration:

K-1 Section Corner for Section 1 and 2, T18N, R17W., on the Township Line.

1838, Sylvester Sibley, D.S., G.L.O.
Set Wood Post, @ 151ks.(9.90') East of Post for Section 35 & 36, T19N,R17W.
#1 Hemlock 24" S56°E 131ks.(8.58')
#2 Beech 10" S45°W 311ks.(20.46')

Undated Corner Record "A-21" M.C.R.C.
Found Iron 9.90' East of corner for 35-36, T19N,R17W

#3 Street Sign S45°E 49.93'
#4 Poplar 12" S80°W 29.35'
#5 Power Pole N85°E 71.04'

1904, R.O. Towns, MCS
Set Iron 15 lk.(9.90') from Corner for 35 & 36, T19N,R17W

1978, Gordon Bonney, RLS 12016
Set 1/2" Iron

1984, Dennis Dunlap, RLS #21759
Re-Set Corner from Ross and Bonney Info; Set 1/2" Re-Rod
#6 Power Pole N50°E 65.68'
#7 Power Pole N75°E 71.26'
#8 NW cor. house foundation 137.73' S35°E
#9 SE Cor. Sec. 35 West 9.89'

B. Description of corner evidence found and/or method applied in restoring or reestablishing corner:

K-1 Section Corner for Sections 1 and 2, T18N, R17W., on the Township Line.

On August 31, 1995, I found a 1/2" Re-rod located in the center-line of LaSalle Road (gravel), 0.3' below road surface, I search the area for other Irons or Markers or any other evidence to dispute this location but found nothing. I did find a 1/2" Re-rod 9.89 feet West for the Section Corner for 35 and 36, T19N, R17W.


Condition of Recorded Witnesses is; #1 Gone #2 Gone #3 found in good cond. #4 Gone
#5 Gone #6 Replace with new Pole #7 same as # 5 #8 found in good cond. #9 Found in good cond.

C. Description of monument for corner and accessories established to perpetuate locating the position of the corner:

K-1 Section corner for Sections 1 and 2, T18N, R17W., on the Township Line.

I replaced 1/2" Re-rod with a 5/8" Re-rod, 2 1/4" long, with an aluminum cap (2 1/2" dia.) stamped MASON COUNTY MONUMENT, I placed the Monument 0.5 feet below Road surface, and is accepted as a careful and faithful reestablishment of the location of the original corner.

OBT #8 NW corner of House foundation S 38° E 137.73'
Power Pole N 60° E 65.50' (60d spike in NW side of Pole)
Red Pine 12" S 21° E 73.37' (60d spike in SW side of tree)
Power Pole N 31° W 46.88' (60d spike in SW side of Pole)

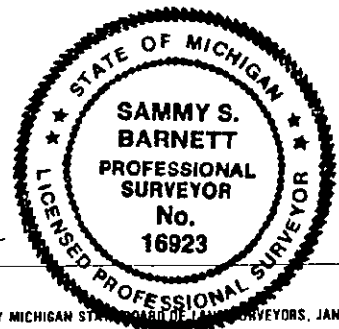

Signed by Sammy S. Barnett Peer Group Reviewed and Approved Date 9-8-95

Surveyor's Michigan License No. 16923 Date: 9-12-95
Kenneth L. Ross
Mason County Surveyor

FORM APPROVED BY MICHIGAN STATE BOARD OF LAND SURVEYORS, JAN. 28, 1971
REVISED MAY 14, 1975
REVISED JAN., 1983