

**SURVEY &
REASONUMENTATION**

DEC 18 1995


COMMISSION

LAND CORNER RECORDATION CERTIFICATE
Filing Requirement of Act 74, Mich. P.A. 1970

For corners in
MASON
(County)

Located In: Corner Code #

- | | | |
|------------------------------------|-------------------------|-------|
| 1. Public Land Survey | T 18 N. R 17 W | K-2 |
| | T _____ R _____ | _____ |
| | T _____ R _____ | _____ |
| | T _____ R _____ | _____ |
| 2. Property Controlling in Section | S _____ T _____ R _____ | _____ |
| | S _____ T _____ R _____ | _____ |
| 3. Miscellaneous Property in Sec. | S _____ T _____ R _____ | _____ |
| | S _____ T _____ R _____ | _____ |

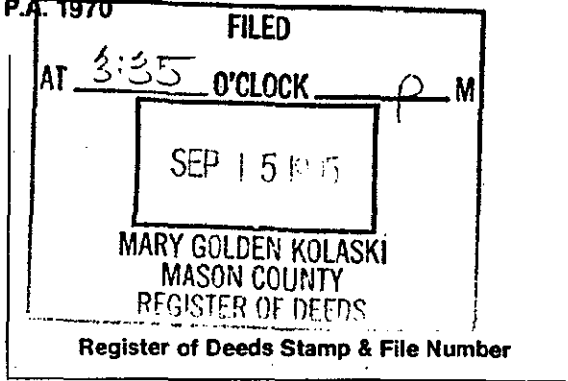

4. Lot No. _____, Recorded Plat _____
5. Private Claims _____

I, Sammy S. Barnett, in a field survey on August 31, 1995, do hereby certify that under requirements of P.A. 74, Michigan P.A. of 1970, the corner points mentioned in lines 1 and 2 above were in conformance with regulations and rules therefore as required in the current manual of survey instructions of the United States Department of the Interior, Bureau of Land Management or by a decree of a Court of Law and/or that the corner points mentioned in lines 3, 4 and 5 above were in conformance with the rules of the Michigan Board of Land Surveyors or by a Decree of a Court of Law; established, re-established, monumented, re-monumented, recovered, found as expressed below:

NOTE: Not more than 4 corners, all in the same town and range, may be recorded on this certificate.

	A	B	C	D	E	F	G	H	I	J	K	L	M
2	6		5		4		3		2	●			
3													
4	7		8		9		10		11		12		
5													
6	18		17		16		15		14		13		
7													
8	19		20		21		22		23		24		
9													
10	30		29		28		27		26		25		
11													
12	31		32		33		34		35		36		
13													

A. Description of original monument and accessories and/or subsequent restoration:

K-2 1/4 Corner for Sections 1 and 2, T18N R17W.

1838, Sylvester Sibley, DS, G.L.O.
Set Wood Post
#1 Beech 10" S64°W 14 lk.(9.24')
#2 Beech 6" N52°E 11 lk.(7.26')
1904, R.O. Towns, MCS
Found Stake, Set Iron Pipe
No witnesses

1960, M.C.R.C. L.C. C-21
Iron Pipe & 3/4" Iron Rod
#3 Hi Line Power Pole SE, 58.2'
#4 Cherry 36" SW 53.3'
#5 Fence Corner, West, 27.9'

1977, Ken Ross, MCS
Replaced 1/2" Iron with 1/2" Re-Rod with RLS Cap # 17634

#6 Maple 36" N60°E 16.88'
#7 Maple 12" S30°W 39.45'
#8 Maple 16" West 22.69'
1978, Gordon Bonney, RLS # 12016
1/2" Iron
Same witnesses as #6, #7 & #8
1983, L. Slater, RLS, M.D.O.T.
1/2" Iron Rod
#9 Maple 16" S35°W 39.58'

B. Description of corner evidence found and/or method applied in restoring or reestablishing corner: (see back)

K-2 1/4 Corner for Sections 1 and 2, T18N, R17W.

On August 31, 1995, I found a 1/2" Re-rod, 0.3 feet below gravel road and at the center-line of LaSalle Road, also found a small rock pile under 1/2" Re-rod, found old record witnesses that fit this location, I found no evidence to dispute this location.

Condition of Record Witnesses is; #1 Gone #2 Gone #3 Power Pole as been replaced in 1980 #4 Found in good cond. #5 Gone #6 Found in good cond. #7 Found in good cond. #8 Found in good cond. #9 Same as #7 #10 Same as #8 #11 Same as #6 #12 Found in good cond.

C. Description of monument for corner and accessories established to perpetuate locating the position of the corner:

K-2 1/4 Corner for Sections 1 and 2, T18N, R17W.

I replaced 1/2" Re-rod with a 5/8" Re-rod, 24" long, with an aluminum cap(2 1/2" in dia.), stamped MASON COUNTY MONUMENT, I placed Monument 1.0 foot below the surface of the gravel road, and is accepted as a careful and faithful reestablishment of the position of the original corner.

- OBT #4 Cherry 56" S 22° W 54.34'(60d spike in SE side of tree)
- OBT #11 Black Oak 48" S 65° E 16.84'(60d spike in NE side of tree)
- OBT #8 S. Maple 18" N 88° W 22.45'(60d spike in South side of tree)
- OBT #12 Oak 12" N 40° W 31.78' (16p nail with shiner in SW side of tree)

Signed by Sammy S. Barnett

Date 9-8-95

Surveyor's Michigan License No. 16923

Peer Group Reviewed and Approved


Date: 9-12-95

FORM APPROVED BY MICHIGAN STATE BOARD OF PROFESSIONAL SURVEYORS, JAN. 28, 1971

REVISED MAY 14, 1975
REVISED JAN., 1983

LIBER 3 PAGE 288

Kenneth L. Ross
Mason County Surveyor

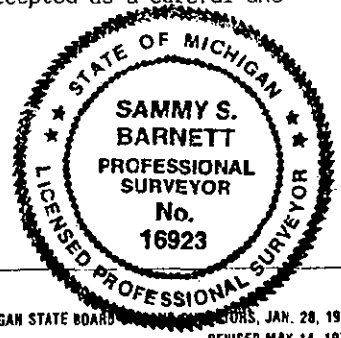

K-2 1/4 Corner for Sections 1 and 2 , T18N, R17W
Continue M.D.O.T.

#10 Maple 17" N85°W 22.27'
#11 Oak 42" S59°E 16.91'
#12 Oak 9" N35°W 31.46'

1993, M.D.O.T. Job # 26667A
Found 1/2" Re-Rod with RLS Cap
Same witnesses as #9, #10, #11 & #12