

# SURVEY & REMONUMENTATION

JAN 23 2001


## LAND CORNER RECORDATION CERTIFICATE

Filing Requirement of Act 74, Mich. P.A. 1970

### SECTION

For corners In: Located In: Corner Code #  
Mason County

- |                                    |                         |       |
|------------------------------------|-------------------------|-------|
| 1. Public Land Survey              | T 18N R 17W             | K-3   |
|                                    | T _____ R _____         | _____ |
|                                    | T _____ R _____         | _____ |
|                                    | T _____ R _____         | _____ |
| 2. Property Controlling in Section | S _____ T _____ R _____ | _____ |
|                                    | S _____ T _____ R _____ | _____ |
| 3. Miscellaneous Property in Sec.  | S _____ T _____ R _____ | _____ |
|                                    | S _____ T _____ R _____ | _____ |

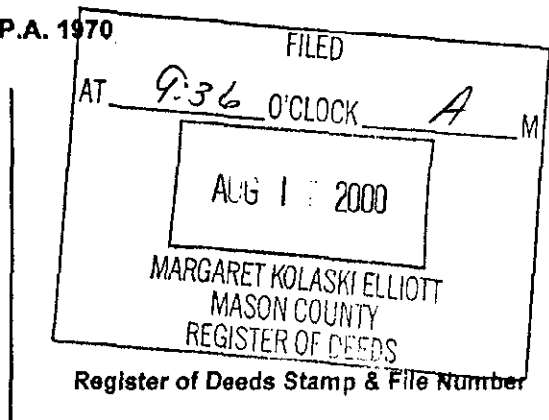

4. Lot No. \_\_\_\_\_ Recorded Plat \_\_\_\_\_  
5. Private Claims \_\_\_\_\_

I, Kenneth L. Ross in a field survey on June 8, 2000, Do hereby certify that under requirements of P.A.74, Michigan P.A. of 1970, the corner points mentioned in lines 1 and 2 above were in conformance with regulations and rules therefore as required in the current manual of survey instructions of the United States Department of the Interior, Bureau of Land Management or by a decree of a Court of Law and/or that the corner points mentioned in lines 3, 4 and 5 above were in conformance with the rules of the Michigan Board of Land Surveyors or by a Decree of a Court of Law; established, re-established, monumented, re-monumented, recovered, found as expressed below:

	A	B	C	D	E	F	G	H	I	J	K	L	M
1													
2	6	5	4	3	2	1							
3													
4	7	8	9	10	11	12							
5													
6	18	17	16	15	14	13							
7													
8	19	20	21	22	23	24							
9													
10	30	29	28	27	26	25							
11													
12	31	32	33	34	35	36							
13													

Section corner common to sections 1, 2, 11, and 12 of T18N., R17W.

**A. Description of original monument and accessories and/or subsequent restoration:**

- |  |  |   |
|--|--|---|
| GLO Sibley 1839<br>Set post<br>Beech 14 S62E 31 lks (20.46') #1<br>Beech 12 N40W 8 lks (5.28') #2  | Bonney RLS 12016 L3, P.60 &57 Act 74<br>Fd. RR spike<br>PP N50E 53.85' #5<br>PP South 85.85' #6<br>St. sign N40W 50.00' #7 | MCRC undated<br>Iron in nest of rocks<br>Fence post NW 42.4' #8<br>TP SE 36.5' #9<br>Fence post S 30.6' #10 |
| Stephens RLS 7318 Unrecorded 1968<br>Fd. RR spike<br>Yield sign N19W 55.20' #3<br>Rd. name sign N45E 51.9' #4<br>TP W/J box N56E 53.81" #5<br>PP S3W 85.88' #6 | Ross 17634 Unrecorded<br>1977 Ex. 5/8" ir<br>1988 no reference<br>1995 Iron in mon. box<br>No witnesses given              |   |

Stephens RLS 7318 Unrecorded 1960  
"from witnesses set RR spike"


**B. Description of corner evidence found and/or method applied in restoring or reestablishing corner:**

I found a 1/2" iron rod in a monument box.  
Condition of the accessories are as follows: 1 through 10 inclusive are gone.  
I found no evidence to dispute the location of this corner

**C. Description of monument for corner and accessories established to perpetuate locating the position of the corner:**

I left the 1/2" iron rod in the monument box in place a drove a 5/8" x 18" iron rod over said 1/2" iron and place a 2 1/2" aluminum cap stamped "Mason County Monument PLS 17634", and accept this as a careful and faithful reestablishment of the position of the original corner

- NE corner of House N36W 145.16'  
 P. Pole N11W 124.55' Set mag. nail E. side  
 P. Pole N58E 61.05' Set mag nail S. side  
 P. Pole S50 W 45.45' Set mag nail NW side  
 5' North of the center of E-W road and in the centerline of a road to the North.

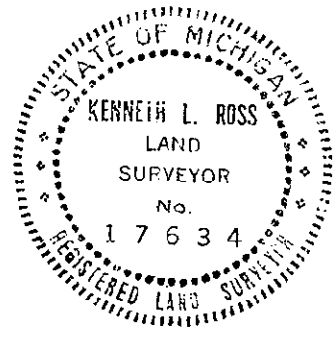

Signed by Kenneth L. Ross Date 8-10-2000

Surveyor's Michigan License No. 17634

FORM APPROVED BY MICHIGAN STATE BOARD OF LAND SURVEYORS, JAN. 28,

Approved by Peer Review Group on 8-10-2000  
Kenneth L. Ross, County Representative [Signature]

1971  
REVISED MAY 14, 1976  
REVISED JAN., 1983  
ADAPTED FOR WORD PROCESSING MARCH, 1993