

**SURVEY & REMONUMENTATION**


MAY 07 1997

COMMISSION

**LAND CORNER RECORDATION CERTIFICATE**  
Filing Requirement of Act 74, Mich. P.A. 1970

For corners in

Mason (County)	Located In:	Corner Code #
1. Public Land Survey	T 18N R 17W	K-07
	T ___ R ___	_____
	T ___ R ___	_____
	T ___ R ___	_____
2. Property Controlling in Section	S ___ T ___ R ___	_____
	S ___ T ___ R ___	_____
3. Miscellaneous Property in Sec.	S ___ T ___ R ___	_____
	S ___ T ___ R ___	_____

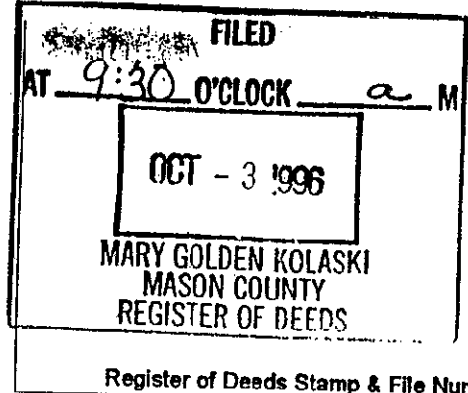

Register of Deeds Stamp & File Number

4. Lot No. \_\_\_\_\_, Recorded Plat \_\_\_\_\_  
5. Private Claims \_\_\_\_\_

I, Sammy S. Barnett, in a field survey on Sept, 19 96 do hereby state that under requirements of P.A. 74, Michigan P.A. of 1970, the corner points mentioned in lines 1 and 2 above were in conformance with regulations and rules therefore as required in the current manual of survey instructions of the United States Department of the Interior, Bureau of Land Management or by a decree of a Court of Law and for that the corner points mentioned in lines 3, 4 and 5 above were in conformance with the rules of the Michigan Board of Land Surveyors or by a Decree of a Court of Law; established, re-established, monumented, recovered, found as expressed below:

NOTE: Not more than 2 corners, all in the same town and range, may be recorded on this certificate.

	A	B	C	D	E	F	G	H	I	J	K	L	M
1													
2	6		5		4		3		2		1		
3													
4	7		8		9		10		11		12		
5													
6	18		17		16		15		14		13		
7													
8	19		20		21		22		23		24		
9													
10	30		29		28		27		26		25		
11													
12	31		32		33		34		35		36		
13													

**A. Description of original monument and accessories and/or subsequent restoration:**

- K-07 Corner common to Sections 13, 14, 23 & 24, T18N, R17W, (Amber) 1838 Syl. Sibley G.L.O. Undated M.C.R.C. #7 Twin Maple <sup>(30")</sup> N.E. 45.4' (#4)
- Set Post 2" Pipe #8 Tel. Pole N. 34.93'
- #1 Beech 16" S67W 17 lks. (11.22') #3 Fence Cor. N. 31.6' #9 Power Pole S. 50.18'
- #2 Beech 10" N75E 30 lks. (19.80') #4 Twin Maple 10" N.E. 45.4' #10 R. Pine 12" S.E. 58.82'
- 1878 J.A. Mitchell Co. Surveyor #5 Elm 15" S. 31.1' 1974 Berry G. Krebs B.L.M.
- Identified old witness, planted #6 Elm 28" S.W. 44.2' Found 2" pipe (no new witnesses)
- stone & stake (no new witnesses) 1974 J. Borsfay M.C.R.C. 1974 K. Ross Act 74 L. 2, P. 14
- Found 2" pipe 1' below surface Found 2" Pipe

**B. Description of corner evidence found and/or method applied in restoring or reestablishing corner:**

- K-07 Corner common to Sections 13, 14, 23 & 24, T18N, R17W, (Amber) #11 Power Pole S. 50.10' (# 9)
- On Sept 6, I found 5/8" X 13" spike in a 2" pipe inside of the existing monument box 0.8' S. of C/L First St. (over) #12 N. Pine (no size) S27E 48.00'
- I found no evidence to dispute this location The condition of the recorded witnesses are: #13 Maple 30" N40E 45.45' (#4&7)

- # 1 Gone # 9 Gone # 16 Gone
- # 2 Gone # 10 Gone # 17 Gone
- # 3 Gone # 11 Same as # 9 # 18 Gone
- # 4 Twin Maple 30" NE 45.4' # 12 Gone # 19 Same as # 9
- # 5 Gone # 13 Same as # 4 & 7 # 20 Same as # 4, 7, 13 & 15
- # 6 Gone # 14 Found stump # 21 same as # 16
- # 7 Same as # 4 # 15 Same as # 4, 7 & 13


**C. Description of monument for corner and accessories established to perpetuate locating the position of the corner:**

- K-07 Corner common to Sections 13, 14, 23 & 24, T18N, R17W, (Amber)
- # 7 Twin Maple 30" N45E 45.40' spike in NW side
- # 8 Tel Pole N. 34.94' spike in E. side
- # 22 Power pole S02W 51.25' spike in E. side
- # 23 R. Pine 13" S33E 84.10' spike in NE side

I replaced the 5/8" x 13" spike and the 2" pipe. in the exact location. with a Standard Mason County Monument in the existing monument box and accepted this location as a careful and faithful reestablishment of the position of the original corner.

Signed by Sammy S. Barnett  
Surveyor's Michigan License No. 16923

Date 9-27-96

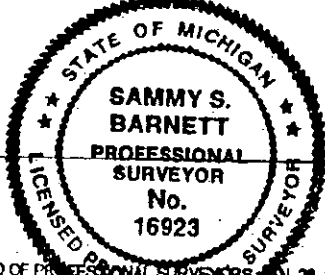

Peer Group Reviewed and Approved  
Date: 9-30-96  
Kenneth L. Ross  
Mason County Surveyor

K-07 Corner common to Sections 13, 14, 23 & 24, T18N, R17W, (Amber)

1984 L. Slater M.D.O.T.

Found 5/8" x 13" spike in 2" ID Pipe

1.3' South of Ex. C/L of First St.

#14 12" + - Stump S25E 48.02' (#12)

#15 35" Oak (Maple) N50E 45.36' (# 4, 7 & 13)

#16 Cor. Fe. post N. 34.93'

#17 Pine 12" S40E 58.82' (# 10)

#18 Power Pole S05E 50.20' (# 9 )

1992 T. Weinert Act 74 L 3 P 54

Found Axel Shaft from K. Ross witnesses

Set monument box

#19 Power pole S. 51.22' ( # 9?)

#20 Maple 36" N40E 45.38' (# 4, 7, 13 & 15)

#21 Fence post N1W 34.91' (# 16 )