


**SURVEY &  
REMONUMENTATION**

MAY 07 1997

**COMMISSION**  
For corners in

**LAND CORNER RECORDATION CERTIFICATE**  
Filing Requirement of Act 74, Mich. P.A. 1970

Mason	Located in:	Corner Code #
(County)		
1. Public Land Survey	T 18N R 17W	K-08
	T R	
	T R	
	T R	
2. Property Controlling in Section	S T R	
3. Miscellaneous Property in Sec.	S T R	
	S T R	
	S T R	
4. Lot No. _____, Recorded Plat _____		
5. Private Claims _____		

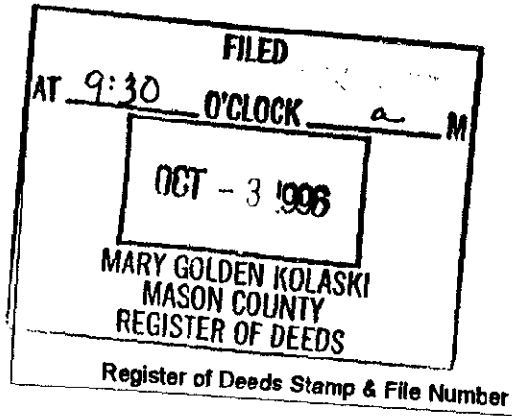

A	B	C	D	E	F	G	H	I	J	K	L
1											
2	6	5	4	3	2	1					
3											
4	7	8	9	10	11	12					
5											
6	18	17	16	15	14	13					
7											
8	19	20	21	22	23	24					
9											
10	30	29	28	27	26	25					
11											
12	31	32	33	34	35	36					
13											

I, Sammy S. Barnett, in a field survey on Sept., 1996 do hereby state that under requirements of P.A. 74, Michigan P.A. of 1970, the corner points mentioned in lines 1 and 2 above were in conformance with regulations and rules therefore as required in the current manual of survey instructions of the United States Department of the Interior, Bureau of Land Management or by a decree of a Court of Law and for that the corner points mentioned in lines 3, 4 and 5 above were in conformance with the rules of the Michigan Board of Land Surveyors or by a Decree of a Court of Law; established, re-established, monumented, recovered, found as expressed below:

NOTE: Not more than 2 corners, all in the same town and range, may be recorded on this certificate.

**A. Description of original monument and accessories and/or subsequent restoration:**

- K-08 1/4 corner common to sections 23 and 24, T18N, R17W (Amber)
- 1838 Syl Sibley G.L.O.
- #1 24" Cedar for corner
- 1878 J.A. Mitchell Co. Surveyor
- #2 Cedar standing (#1)
- 1974 Barry G. Krebs B.L.M.
- #3 Twin Cedar stumps 24", 5' high
- with old fence lines N. & W., no other Cedar stumps in area. (# 1 & 2)
- 1988 K. Ross
- Existing 1" pipe on E. side of 5' high cedar stump (# 1, 2 & 3)
- #4 Hemlock 8" s52E 41.70'
- #5 Cedar 8" N8W 22.87'
- #6 Hemlock 14" S62W 27.84'

**B. Description of corner evidence found and/or method applied in restoring or reestablishing corner:**


- K-08 1/4 corner common to sections 23 and 24, T18N, R17W (Amber)
- On Sept 5, I found Twin Cedar Stumps. Old fences N. & W. & 1" pipe with Ross cap on West side of Stumps. I found no evidence to dispute this location. The condition of the recorded witnesses are:
- # 1 Found stump
- # 2 same as # 1
- # 3 Same as # 1 & 2
- # 4 Dead
- # 5 Cedar 8" N8W 22.87' spike in W side
- # 6 Balsm 16" N62W 27.84' spike in SE side

**C. Description of monument for corner and accessories established to perpetuate locating the position of the corner:**

- K-08 1/4 corner common to sections 23 and 24, T18N, R17W (Amber)
- I set a Standard Mason County Monument. in the exact location of the 1" pipe and accepted this location as the perpetuation of the location of the original corner.
- # 5 Cedar 8" N8W 22.87' spike in W. side
- # 6 Balsam 16" N62W 27.84' spike in SE side
- # 7 Balsam 14" N58W 40.06' spike in NE side
- # 8 Tamarack 18" N37W 46.41' spike in NE side

Signed by Sammy S. Barnett  
Surveyor's Michigan License No. 16923

Date 9-25-96

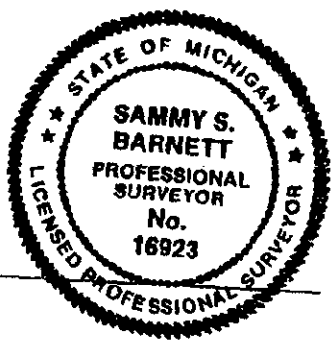

Peer Group Reviewed and Approved  
Date: 9-30-96  
Kenneth L. Ross  
Mason County Surveyor