

SURVEY & REMONUMENTATION


APR 28 1995

COMMISSION

LAND CORNER RECORDATION CERTIFICATE Filing Requirement of Act 74, Mich. P.A. 1970

For corners in

<u>MASON</u> (County)	Located In:	Corner Code #
1. Public Land Survey	T <u>18N</u> R <u>17W</u>	K-11
	T _____ R _____	
	T _____ R _____	
	T _____ R _____	
2. Property Controlling in Section	S _____ T _____ R _____	<u>Sec. 1</u>
	S _____ T _____ R _____	
3. Miscellaneous Property in Sec.	S _____ T _____ R _____	
	S _____ T _____ R _____	
4. Lot No. _____, Recorded Plat _____		
5. Private Claims _____		

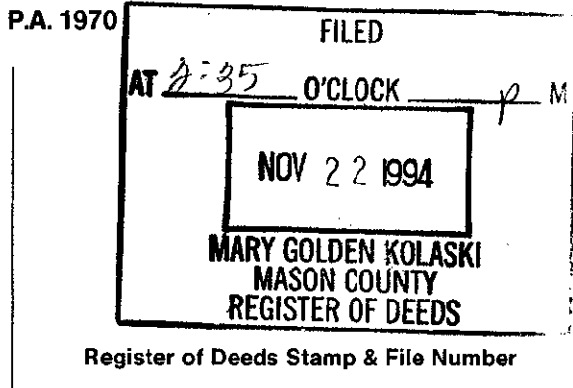

I, Theodore H. Weinert, in a field survey on OCTOBER, 19 94, do hereby certify that under requirements of P.A. 74, Michigan P.A. of 1970, the corner points mentioned in lines 1 and 2 above were in conformance with regulations and rules therefore as required in the current manual of survey instructions of the United States Department of the Interior, Bureau of Land Management or by a decree of a Court of Law and/or that the corner points mentioned in lines 3, 4 and 5 above were in conformance with the rules of the Michigan Board of Land Surveyors or by a Decree of a Court of Law; established, re-established, monumented, re-monumented, recovered, found as expressed below:

NOTE: Not more than 4 corners, all in the same town and range, may be recorded on this certificate.

	A	B	C	D	E	F	G	H	I	J	K	L	M
2	6	5	4	3	2	1							
3													
4	7	8	9	10	11	12							
5													
6	18	17	16	15	14	13							
7													
8	19	20	21	22	23	24							
9													
10	30	29	28	27	26	25							
11													
12	31	32	33	34	35	36							
13													

A. Description of original monument and accessories and/or subsequent restoration:


K-11 Section Corner, Secs. 25, 26, 35 & 36
 G.L.O. Notes Set Post
 July, 1838, Sylvester Sibley
 16" Cedar N 21 E 14 lks
 14" Cedar S 22 W 10 lks
 Found no other surveys of record for this corner

B. Description of corner evidence found and/or method applied in restoring or reestablishing corner:

K-11 Section Corner, Secs. 25, 26, 35 & 36
 Found 1" ID pipe 1.5' long and pinched on end below ground, next to old corner fence post

C. Description of monument for corner and accessories established to perpetuate locating the position of the corner:

K-11 Section Corner, Secs. 25, 26, 35 & 36
 Set 5/8" X 36" rerod with standard 2 1/2" cap stamped "Mason County Remonumentation" in place of 1" pipe.
 Old Fence Corner Post East 1.0'
 8" Blm S 85 E 7.70'
 4" Db1. Cedar N 30 E 15.00'
 6' Cedar N 30 W 45.45'
 4" Blm South 33.80'
 Fence Line North East & West

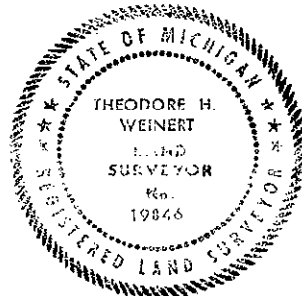

Peer Group Reviewed and Approved
 Date: 11-16-94
 Kenneth L. Ross
 Mason County Surveyor

Signed by Theodore H. Weinert Date 11/15/94
 Surveyor's Michigan License No. 19846