


**SURVEY &
REMONUMENTATION**

DEC 18 1995

COMMISSION LAND CORNER RECORDATION CERTIFICATE
Filing Requirement of Act 74, Mich. P.A. 1970

For corners in

MASON (County)	Located In:	Corner Code #
1. Public Land Survey	T 18 N R 17 W	L-1
	T _____ R _____	_____
	T _____ R _____	_____
	T _____ R _____	_____
2. Property Controlling in Section	S _____ T _____ R _____	_____
	S _____ T _____ R _____	_____
3. Miscellaneous Property in Sec.	S _____ T _____ R _____	_____
	S _____ T _____ R _____	_____
4. Lot No. _____, Recorded Plat _____		
5. Private Claims _____		

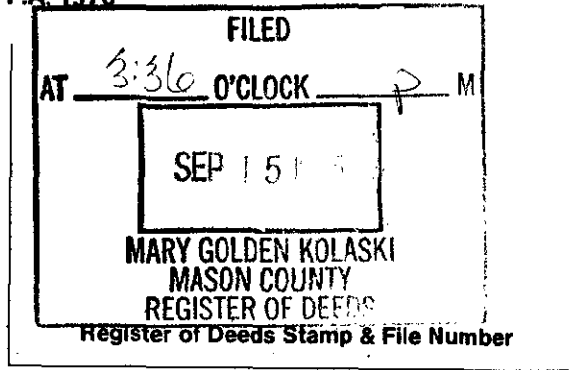

A	B	C	D	E	F	G	H	I	J	K	L	M
2	6		5		4		3		2		1	
3												
4	7		8		9		10		11		12	
5												
6	16		17		16		15		14		13	
7												
8	19		20		21		22		23		24	
9												
10	30		29		28		27		26		25	
11												
12	31		32		33		34		35		36	
13												

I, Sammy S. Barnett, in a field survey on September 5, 19 95, do hereby certify that under requirements of P.A. 74, Michigan P.A. of 1970, the corner points mentioned in lines 1 and 2 above were in conformance with regulations and rules therefore as required in the current manual of survey instructions of the United States Department of the Interior, Bureau of Land Management or by a decree of a Court of Law and/or that the corner points mentioned in lines 3, 4 and 5 above were in conformance with the rules of the Michigan Board of Land Surveyors or by a Decree of a Court of Law; established, re-established, monumented, re-monumented, recovered, found as expressed below:

NOTE: Not more than 4 corners, all in the same town and range, may be recorded on this certificate.

A. Description of original monument and accessories and/or subsequent restoration:

L-1 North 1/4 Corner for Section 1, T18N, R17W.

<u>1838, Mullett & Brookfield, G.L.O. Boundary</u> Corner not set by G.L.O. Survey	<u>No Date, M.C.R.C., L.2, P.57</u> Iron & Crockery, L.C.R. A-23	<u>1983, L. Slater, L.2, P.117</u> Found 1/2" Iron Pipe
<u>1904, R.O. Towns, M.C.S.</u> Found Stake and Crockery, Set Iron	<u>1978, G. Bonney, RLS 12016</u> Set 1/2 Iron at Gov't distance West	<u>#4 Maple 4" N18°W 61.55'</u>
<u>Book 2, Page 81, also repeated in Book 4,</u> <u>Page 144, record distance West 2620.20',</u> <u>and distance East 2624.16' to NE cor.</u>	<u>from NE Cor. (mon. box)</u> <u>#1 Poplar 12" N54°W 57.32'</u> <u>#2 Poplar 8" North 31.20'</u> <u>#3 Poplar 6" N45°E 35.75'</u>	<u>#5 Poplar 7" N17°E 52.37'</u> <u>#6 Poplar 14" North 68.48'</u> <u>#7 Poplar 7" N41° E 58.92'</u> <u>#8 1/2" Iron Bar, West, 4.97'</u>

B. Description of corner evidence found and/or method applied in restoring or reestablishing corner:

L-1 North 1/4 corner for Section 1, T18N, R17W.

On September 5, 1995, I found a 1/2" Re-rod in the center-line of Decker Road (gravel), this position fit the found Witnesses I found by L. Slater from 1983, I search for other Irons or Markers or any other evidence, but found nothing to dispute this location for the corner.

Condition of Recorded Witnesses is; #1 Cone #2 Cone #3 Cone #4 Found in good cond. #5 Found in good cond. #6 Found dead #7 Gone #8 ~~Gone~~ Found

C. Description of monument for corner and accessories established to perpetuate locating the position of the corner:

L-1 North 1/4 corner for Section 1, T18N, R17W.

I replaced 1/2" Re-rod with a 5/8" Re-rod, 24" long, with an aluminum cap (2 1/2" in dia.) stamped MASON COUNTY MONUMENT, I placed Monument 0.5 feet below gravel road, and is accepted as a careful and faithful reestablishment of the position of the original corner.

- OBT #4 Red Maple 8" N 18° W 61.55' (60d spike in NE side of tree)
- OBT #5 Poplar 12" N 17° E 55.28' (60d spike in NW side of tree)
- OBT #6 Poplar 14" North 68.48' (M.D.O.T. shiner & 60d spike in West side of tree)
- Power Pole S 74° E 136.56' (fd. 60d spike in North side of pole)
- North & Top -center of culvert N 08° W 26.90'

Signed by Sammy S. Barnett Date 9-8-95

Surveyor's Michigan License No. 16923

Peer Group Reviewed and Approved
Date: 9-12-95

Kenneth L. Röss
Mason County Surveyor



FORM APPROVED BY MICHIGAN STATE BOARD OF LAND SURVEYORS, JAN. 28, 1971
REVISED MAY 14, 1975
REVISED JAN., 1983