

SURVEY & REMONUMENTATION

DEC 1 8 1995

COMMISSION

LAND CORNER RECORDATION CERTIFICATE
 Filing Requirement of Act 74, Mich. P.A. 1970

For corners in


MASON _____
 (County)

Located In: _____ Corner Code # _____

1. Public Land Survey T 18N R 17W M-01
 T _____ R _____
 T _____ R _____
 T _____ R _____

2. Property Controlling S _____ T _____ R _____
 in Section S _____ T _____ R _____

3. Miscellaneous S _____ T _____ R _____
 Property in Sec. S _____ T _____ R _____

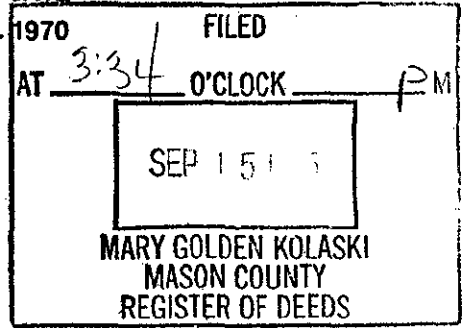

Register of Deeds Stamp & File Number

4. Lot No. _____, Recorded Plat _____
 5. Private Claims _____

| | A | B | C | D | E | F | G | H | I | J | K | L | M |
|----|----|---|----|---|----|---|----|---|----|---|----|---|---|
| 2 | 6 | | 5 | | 4 | | 3 | | 2 | | 1 | | |
| 3 | | | | | | | | | | | | | |
| 4 | 7 | | 8 | | 9 | | 10 | | 11 | | 12 | | |
| 5 | | | | | | | | | | | | | |
| 6 | 18 | | 17 | | 16 | | 15 | | 14 | | 13 | | |
| 7 | | | | | | | | | | | | | |
| 8 | 19 | | 20 | | 21 | | 22 | | 23 | | 24 | | |
| 9 | | | | | | | | | | | | | |
| 10 | 30 | | 29 | | 28 | | 27 | | 26 | | 25 | | |
| 11 | | | | | | | | | | | | | |
| 12 | 31 | | 32 | | 33 | | 34 | | 35 | | 36 | | |
| 13 | | | | | | | | | | | | | |

I, Sammy S. Barnett, in a field survey on September 8, 1995, do hereby certify that under requirements of P.A. 74, Michigan P.A. of 1970, the corner points mentioned in lines 1 and 2 above were in conformance with regulations and rules therefore as required in the current manual of survey instructions of the United States Department of the Interior, Bureau of Land Management or by a decree of a Court of Law and/or that the corner points mentioned in lines 3, 4 and 5 above were in conformance with the rules of the Michigan Board of Land Surveyors or by a Decree of a Court of Law; established, re-established, monumented, re-monumented, recovered, found as expressed below:

NOTE: Not more than 4 corners, all in the same town and range, may be recorded on this certificate.

A. Description of original monument and accessories and/or subsequent restoration:

M-1 Township Corner, NE Corner Section 1, T18N, R17W

1838, Mullett & Brookfield, G.L.O.

Set Wood Post

#1 Beech 20" S 13° E 81ks(5.28')

#2 Beech 10" N 48° W 44ks(29.04')

1895, J.W. Griswald

Monument not given, no witnesses

1904, R.O. Towns, M. C. S.

"X" in stone & Crockery

No witnesses

1983, Lawrence Slater, RLS 7439

Found 1 1/2" Bar in Monument box

#3 Power Pole N 65° W 44.93'

#4 Tele-Pole S 25° E 57.95'

#5 Tw. Ash S 74° E 114.20'

#6 Power Pole N 73° E 57.57'

SEE BACK, OVER

B. Description of corner evidence found and/or method applied in restoring or reestablishing corner:

M-1 Township Corner, NE Corner, Section 1, T18N, R17W

On September 8, 1995, I found a Monument Box with a Rail-Road Spike placed in center of box, Rail-road spike is 1.0 foot West of center-line of U.S. 31, Due to resent road construction all of the recorded witnesses have been destroyed, Found no other evidence to dispute this location for the corner.

C. Description of monument for corner and accessories established to perpetuate locating the position of the corner:

M-1 Township Corner, NE Corner, Section 1, T18N, R17W

I replaced the rail-road spike with a 5/8" Re-rod, 24" long, with an aluminum cap(2 1/2" in dia.), stamped MASON COUNTY MONUMENT, Monument was placed inside exciting monument box, and is accepted as a careful and faithful reestablishment of the position of the original corner.

Power Pole N 65° W 71.35'(P.K. nail in NE side of Pole)

Power Pole N 67° E 50.32'(P.K. nail in NE side of Pole)

Power Pole S 64° E 82.95'(P.K. nail in SE side of Pole)

S. Maple 16" N 58° E 121.90'(60d spike in SE side of tree)

Signed by Sammy S. Barnett


Date 9-8-95

Surveyor's Michigan License No. 16923

Peer Group Reviewed and Approved

Date: 9-12-95
Kenneth L. Rost
 Mason County Surveyor

FORM APPROVED BY MICHIGAN STATE BOARD OF LAND SURVEYORS, JAN. 28, 1971
 REVISED MAY 14, 1975
 REVISED JAN., 1983

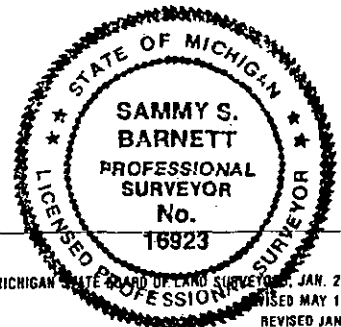

M-01 Township Corner, NE Corner Section 1, T18N, R17W

No date, Anthony Slawinski, M.C.R.C.

Axial Shaft in Monument Box

#7 Power Pole N 60° E 57.57'
#8 Tele-Pole S 30° E 57.92'
#9 Power pole N 35° W 45.03'

1989, Mi. Dp. Trsp.

1¼" Bar in Monument Box

#10 Power Pole N 65° W 44.93'
#11 Tele-Pole S 25° E 57.95'
#12 Tw. Ash 37" S 74° E 114.20'
#13 Power Pole N 73° E 57.57'

1993, Kenneth Ross M.C.S.

Found Monument box

NO WITNESSES GIVEN