

RECORDED

DEC 29 1998

LAND CORNER RECORDATION CERTIFICATE

Filing Requirement of Act 74, Mich. P.A. 1970

For corners in SECTION MASON (County)

Located In:

Corner Code #

- 1. Public Land Survey T 18N R 16W A-7 T 18N R 17W M-7

- 4. Lot No. Recorded Plat 5. Private Claims

I, Kenneth L. Ross, in a field survey on August 24 19 98, do hereby certify that under requirements of P.A. 74, Michigan P.A. of 1970, the corner points mentioned in lines 1 and 2 above were in conformance with regulations and rules therefore as required in the current manual of survey instructions of the United States Department of the Interior, Bureau of Land Management or by a decree of a Court of Law and/or that the corner points mentioned in lines 3, 4 and 5 above were in conformance with the rules of the Michigan Board of Land Surveyors or by a Decree of a Court of Law, established, re-established, monumented, re-monumented, recovered, found as expressed below.

NOTE: Not more than 4 corners, all in the same town and range, may be recorded on this certificate.

A. Description of original monument and accessories and/or subsequent restoration:

A-7 Section Corner for Sections 18 and 19, T18N-R16W and Sections 13 and 24, T18N-R17W.

1839, Mullett and Brookfield, G.L.O., boundary survey Set Wood Post #1 Hemlock 8" S 29 W 17 lks. (11.22') #2 Hemlock 9" N 36 W 22 lks. (14.52')

1974, Ken Ross, RLS #17634 Found P. K. nail over Iron #3 Power Pole N 60 W 22.95' #4 Power Pole N 30 E 45.95' #5 SE Cor. of Building N 40 W 115.34' (liber 2, page 11)

B. Description of corner evidence found and/or method applied in restoring or reestablishing corner:

A-7 Section Corner for Sections 18 and 19, T18N-R16W and Sections 13 and 24, T18N-R17W.

On August 24, 1998, I found 5/8" Iron Rod, inside an existing monument box. I found no evidence dispute this location for the corner.

Condition of record witnesses are as follows: #1 Gone #2 Gone #3 Found in good condition

#4 Found in good condition #5 Found in good condition

C. Description of monument for corner and accessories established to perpetuate locating the position of the corner:


A-7 Section Corner for Sections 18 and 19, T18N-R16W and Sections 13 and 24, T18N-R17W.

I placed an aluminum cap, stamped MASON COUNTY MONUMENT, over the top of existing 5/8" iron rod, inside existing monument box. This corner is accepted as a careful and faithful re-establishment of the position of the original corner.

- xt. "BT" #3 Power Pole N 60 W 22.95' (60d spike in SE side of pole) xt. "BT" #5 SE corner of Building (house) N 40 W 115.34' (corner of foundation) xt. "BT" #4 Power Pole N 30 E 46.28' (set P.K. nail in NW side of pole) av "BT" #6 Blue Spruce 16" S 56 E 37.6' (face of the tree in yard)

igned by Kenneth L. Ross Surveyor's Michigan License No. 17634

Date Sept 8, 1998

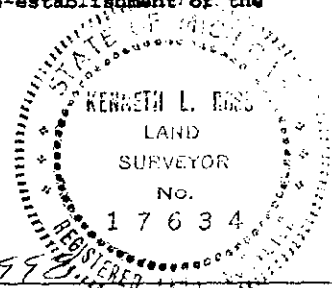

FORM APPROVED BY MICHIGAN STATE BOARD OF LAND SURVEYORS, JAN. 28, 1971 REVERSED MAY 14, 1978 REVISED JAN. 1983

ADAPTED FOR WORD PROCESSING MARCH, 1993

Date 9-8-98

Table with 13 rows and 12 columns (A-L) containing numbers 1-36 in a grid pattern.

Register of Deeds Stamp & File Number. Filed at 10 O'clock 21 A.M. MARY GOLDEN KOLESKI