

SURVEY & REMONUMENTATION

MAR 16 1998

LAND CORNER RECORDATION CERTIFICATE
Filing Requirement of Act 74, Mich. P.A. 1970


SECTION
For corners in

Located In: _____ Corner Code # _____

1. Public Land Survey T 18N R 17W D-1
 T _____ R _____
 T _____ R _____
 T _____ R _____

2. Property Controlling S _____ T _____ R _____
 in Section S _____ T _____ R _____

3. Miscellaneous S _____ T _____ R _____
 Property in Sec. S _____ T _____ R _____

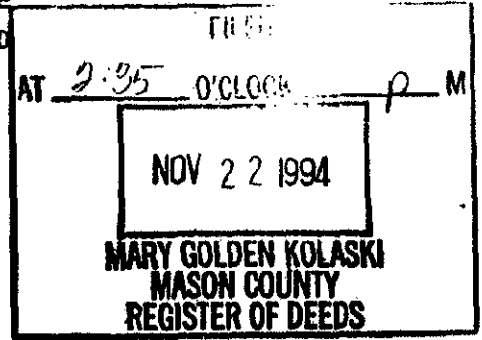

Register of Deeds Stamp & File Number

4. Lot No. _____, Recorded Plat _____
 5. Private Claims _____

	A	B	C	D	E	F	G	H	I	J	K	L	M
2	6	5	4	3	2								
3													
4	7	8	9	10	11	12							
5													
6	18	17	16	15	14	13							
7													
8	19	20	21	22	23	24							
9													
10	30	29	28	27	26	25							
11													
12	31	32	33	34	35	36							
13													

I, Theodore H. Weinert, in a field survey on JULY, 19 94, do hereby certify that under requirements of P.A. 74, Michigan P.A. of 1970, the corner points mentioned in lines 1 and 2 above were in conformance with regulations and rules therefore as required in the current manual of survey instructions of the United States Department of the Interior, Bureau of Land Management or by a decree of a Court of Law and/or that the corner points mentioned in lines 3, 4 and 5 above were in conformance with the rules of the Michigan Board of Land Surveyors or by a Decree of a Court of Law; established, re-established, monumented, re-monumented, recovered, found as expressed below:

NOTE: Not more than 4 corners, all in the same town and range, may be recorded on this certificate.

A. Description of original monument and accessories and/or subsequent restoration:


D-1 N. 1/4 Corner, Sec. 5
 Corner not set during original government survey
 May, 1899, R. O. Towns Pd existing stake by former surveyor (Book 2, Page 71)
 Ken Ross, PLS, Pd T iron set by
 Consumer's Power Co. LCRC (Liber 2, Page 25)

B. Description of corner evidence found and/or method applied in restoring or reestablishing corner:

D-1 N. 1/4 Corner, Sec. 5
 Found T iron
 Fit as described by Ken Ross, PLS.
 This corner location is accepted as a careful and faithful perpetuation of the original corner.

C. Description of monument for corner and accessories established to perpetuate locating the position of the corner:

D-1 N. 1/4 Corner, Sec. 5
 Reset T iron with a 5/8" X 36" rerod with standard 2 1/2" cap stamped "Mason County Remonumentation".
 6" Maple N 24 E 38.85'
 12" Maple N 54 W 3.74'
 24" Beech S 14 W 16.83'
 10" Maple S 54 E 19.58'
 8" Maple N 86 W 66.55'
 On Fence Line to South
 E-W Fence Line 3.0' North
 S 1/4 Corner 32, T19N, R17W, West 91.47'

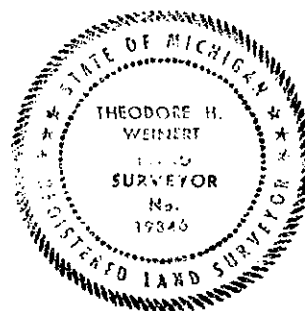

Signed by Theodore H. Weinert Date 10/4/94

Surveyor's Michigan License No. 19846 Peer Group Reviewed and Approved

FORM APPROVED BY MICHIGAN STATE BOARD OF LAND SURVEYORS, JAN. 28, 1971
 and Revised MAY 14, 1975
 REVISED JAN., 1983

LIBER 3 PAGE 226

Date: 10-5-94
 Kenneth L. Ross
 Mason County Surveyor

Date: Feb 25 1997
 Kenneth L. Ross