

SURVEY & REMONUMENTATION

MAR 16 1998


SECTION

LAND CORNER RECORDATION CERTIFICATE

Filing Requirement of Act 74, Mich. P.A. 1970

For corners in

<u>MASON</u> (County)	Located In:	Corner Code #
1. Public Land Survey	T 18N R 17W	E-1
	T R	
	T R	
	T R	
2. Property Controlling in Section	S T R	<i>Seg. 2</i>
	S T R	
3. Miscellaneous Property in Sec.	S T R	
	S T R	
4. Lot No. _____, Recorded Plat _____		
5. Private Claims _____		

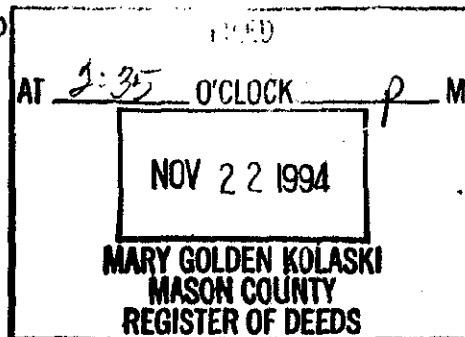

Register of Deeds Stamp & File Number

A	B	C	D	E	F	G	H	I	J	K	L	M
2	6	5	4	3	2	1						
3												
4	7	8	9	10	11	12						
5												
6	18	17	16	15	14	13						
7												
8	19	20	21	22	23	24						
9												
10	30	29	28	27	26	25						
11												
12	31	32	33	34	35	36						
13												

I, Theodore H. Weinert, in a field survey on JULY 1994, do hereby certify that under requirements of P.A. 74, Michigan P.A. of 1970, the corner points mentioned in lines 1 and 2 above were in conformance with regulations and rules therefore as required in the current manual of survey instructions of the United States Department of the Interior, Bureau of Land Management or by a decree of a Court of Law and/or that the corner points mentioned in lines 3, 4 and 5 above were in conformance with the rules of the Michigan Board of Land Surveyors or by a Decree of a Court of Law; established, re-established, monumented, re-monumented, recovered, found as expressed below:

NOTE: Not more than 4 corners, all in the same town and range, may be recorded on this certificate.

A. Description of original monument and accessories and/or subsequent restoration:

E-1 Section Corner, Secs. 4 & 5
 1837 Newberry Set Post
 1838 Sylvester Sibley missed post by Newberry
 26 lks East
 20" Beech S 19 W 45 lks
 8" Beech S 39 E 50 lks
 September, 1899, R. O. Towns Pd stake for corner
 46 lks east of corner common to sections 32 & 33,
 T19N, R17W (Book 2, Page 71)

October 4, 1977, Ken Ross, PLS, reestablished corner and set 1" X 24" pipe and cap #17634 46 lks. (30.36') east of corner common to sections 32 & 33, T19N, R17W.

B. Description of corner evidence found and/or method applied in restoring or reestablishing corner:

E-1 Section Corner, Secs. 4 & 5
 Found 1" X 24" pipe and cap #17634.
 Fit distances within reason as recorded by R. O. Towns.
 This corner location is accepted as a careful and faithful perpetuation of the original corner.

C. Description of monument for corner and accessories established to perpetuate locating the position of the corner:

E-1 Section Corner, Secs. 4 & 5
 Replaced 1" X 24" pipe with 5/8" X 36" rebar with standard 2 1/2" cap stamped "Mason County Remonumentation", 1.0' below gravel road surface.
 10" W. Pine S 03 E 47.70'
 Stop Sign Post N 45 E 13.58'
 6" Maple N 15 E 56.84'
 12" Maple N 30 W 103.87'
 Tel Box N 83 W 59.00'
 Corner Common to Sections 32 & 33, T18N, R17W, West 30.36'



Signed by Theodore H. Weinert Date 10/17/94
 Surveyor's Michigan License No. 19876

Peer Group Review and Approved Date: 10-25-94
 Approved by Kenneth T. Ross
 Peer Group Review and Approved Date: 10-25-94
 Approved by Kenneth T. Ross