

# SURVEY & REMONUMENTATION

JAN 23 2001

## LAND CORNER RECORDATION CERTIFICATE


### SECTION

Filing Requirement of Act 74, Mich. P.A. 1970

FILED

For corners In: Located In: Corner Code #  
Mason County

- |                                    |   |     |   |     |      |
|------------------------------------|---|-----|---|-----|------|
| 1. Public Land Survey              | T | 18N | R | 18W | I-12 |
|                                    | T |     | R |     |      |
|                                    | T |     | R |     |      |
|                                    | T |     | R |     |      |
| 2. Property Controlling in Section | S | T   | R |     |      |
|                                    | S | T   | R |     |      |
| 3. Miscellaneous Property in Sec.  | S | T   | R |     |      |
|                                    | S | T   | R |     |      |

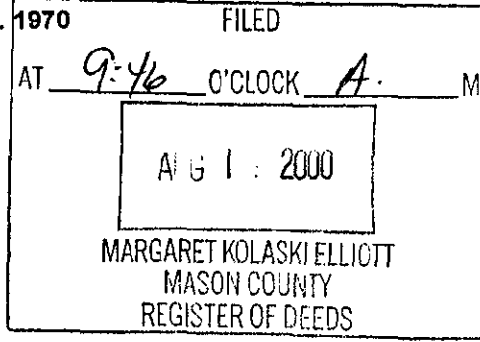

Register of Deeds Stamp & File Number

4. Lot No. \_\_\_\_\_, Recorded Plat \_\_\_\_\_  
5. Private Claims \_\_\_\_\_

	A	B	C	D	E	F	G	H	I	J	K	L	M
1													
2	6	5	4	3	2	1							
3													
4	7	8	9	10	11	12							
5													
6	18	17	16	15	14	13							
7													
8	19	20	21	22	23	24							
9													
10	30	29	28	27	26	25							
11													
12	31	32	33	34	35	36							
13													

I, Kenneth L. Ross in a field survey on July 25, 2000, Do hereby certify that under requirements of P.A. 74, Michigan P.A. of 1970, the corner points mentioned in lines 1 and 2 above were in conformance with regulations and rules therefore as required in the current manual of survey instructions of the United States Department of the Interior, Bureau of Land Management or by a decree of a Court of Law and/or that the corner points mentioned in lines 3, 4 and 5 above were in conformance with the rules of the Michigan Board of Land Surveyors or by a Decree of a Court of Law; established, re-established, monumented, re-monumented, recovered, found as expressed below:

$\frac{1}{4}$  corner common to sections 34 and 35 of 18N, R18W

**A. Description of original monument and accessories and/or subsequent restoration:**

- GLO Sibley 1838
- 8' Sugar N62E 25 links (16.5') #1
- 6' Sugar S28W 16 links (10.56') #2
  
- Fuharty RLS 18223 L337 P792 & L342 P89 1986
- Fd. PK nail over pipe
- 28" Maple S3W 26.86' #3
- Sign post S70W 43.32' #4
- PP N01W 26.12' #5
  
- Stephens RLS 7318 undated
- iron pipe in dirt road
- 6' maple NW 37.3' #6
- Pole NE 73.0' #7
- Pole SW 63.6' #8
- 8' Ash SW 53.0' #9

**B. Description of corner evidence found and/or method applied in restoring or reestablishing corner:**


I found and removed a  $\frac{1}{2}$ " x 18" iron rod 6" below the surface. At 14" below the surface I found a  $\frac{3}{4}$ " bent angle Iron. I set a Harrison monument in a monument box in the exact location of the  $\frac{1}{2}$ " x 18" iron rod. I did not remove the  $\frac{3}{4}$ " bent iron.

The condition of the witnesses are as follows: 1 and 2 are gone #3 is good but is a red oak, 4,6 and 9 are gone. 5,7 and 8 are in good condition.

I found nothing to dispute the location of this corner.

**C. Description of monument for corner and accessories established to perpetuate locating the position of the corner:**

- I set a Harrison monument stamped "Mason County Monument PLS 17634" in a monument box, I accepted this as a careful and faithful reestablishment of the position of the original corner. The corner is 2' south of the road centerline.
- 40" R. oak S00E 28.75' ex. 60 d spike W. side #3
- 14" Maple S34E 34.25' ex. 60 d spike in W. side
- PP N39E 73.16' ex. 16d nail in SE side #7
- PP N02E 26.10' ex. 16d nail in W side #5
- PP S55W 63.50' ex. 60d nail in E side #8

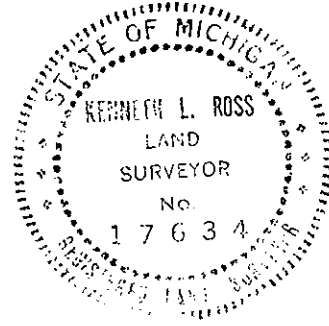

Signed by *[Signature]* Date 8-10-2000  
Surveyor's Michigan License No. 17634

Approved by Peer Review Group on 8-10-2000  
Kenneth L. Ross, County Representative *[Signature]*

FORM APPROVED BY MICHIGAN STATE BOARD OF LAND SURVEYORS, JAN. 28, 1971  
REVISED MAY 14, 1976  
REVISED JAN. 1983  
ADAPTED FOR WORD PROCESSING MARCH, 1993