

**SURVEY &
REMONUMENTATION**

JAN 23 2001

LAND CORNER RECORDATION CERTIFICATE

SECTION

Filing Requirement of Act 74, Mich. P.A. 1970

FILED
AT 9:47 O'CLOCK A. M.
AUG 17 2000
MARGARET KOLASKI ELLIOTT
MASON COUNTY
REGISTER OF DEEDS

For corners In: Located In: Corner Code #

Mason County

- | | | | |
|------------------------------------|-------|-------|------|
| 1. Public Land Survey | T 18N | R 18W | J-11 |
| | T | R | |
| | T | R | |
| | T | R | |
| 2. Property Controlling in Section | S | T | R |
| | S | T | R |
| 3. Miscellaneous Property in Sec. | S | T | R |
| | S | T | R |
4. Lot No. _____ Recorded Plat _____
5. Private Claims _____

Register of Deeds Stamp & File Number

	A	B	C	D	E	F	G	H	I	J	K	L	M
1													
2	6	5	4	3	2	1							
3													
4	7	8	9	10	11	12							
5													
6	18	17	16	15	14	13							
7													
8	19	20	21	22	23	24							
9													
10	30	29	28	27	26	25							
11					○								
12	31	32	33	34	35	36							
13													

I, Kenneth L. Ross in a field survey on July 25, 2000, Do hereby certify that under requirements of P.A. 74, Michigan P.A. of 1970, the corner points mentioned in lines 1 and 2 above were in conformance with regulations and rules therefore as required in the current manual of survey instructions of the United States Department of the Interior, Bureau of Land Management or by a decree of a Court of Law and/or that the corner points mentioned in lines 3, 4 and 5 above were in conformance with the rules of the Michigan Board of Land Surveyors or by a Decree of a Court of Law; established, re-established, monumented, re-monumented, recovered, found as expressed below:

Quarter Section corner common to section 26 and 35 of T18N, R18W.

A. Description of original monument and accessories and/or subsequent restoration:

- | | |
|-----------------------------------|--------------------------------|
| GLO Sibley 1839 set post | Fluharty PLS 18223 L 329 P 845 |
| 30" pine S35W 6 lks. (3.96') #1 | Fd. concrete monument |
| 14" Maple N82E 11 lks. (7.26') #2 | PP N4E 15.84' #6 |
| | 8" cedar N38E 58.45' #7 |
| MCRC undated | 10" cherry N75W 55.43' #8 |

- Concrete monument
PP NE 78.3' #3
PP SSW 2.7' #4
Center of cluster of beach (blazed)
NW 70.2' #5

- Hays PLS 25847 L305 P 220
1982
Conc. mon. N. side rd.
(no witnesses)

B. Description of corner evidence found and/or method applied in restoring or reestablishing corner:

I found a 4" x 48" concrete monument 70 ft. North of the centerline of Iris Road

The condition of the accessories is as follows: 1, 2, 3 and 4 are gone. 5 is good but no nail found, 6 and 8 are good. 7 is good but no nail was found.


I found nothing to dispute the location of this corner.

C. Description of monument for corner and accessories established to perpetuate locating the position of the corner:

I found a 4" x 48" concrete monument 70 ft. North of the centerline of Iris Road. I replaced the concrete monument with a Harrison Monument stamped "Mason County Monument PLS 17634". I accepted this as a careful and faithful reestablishment of the position of the original corner. There are no well defined occupation lines to the North and South.

- 8" Cherry S85W 82.37' (set 60d nail SE side)
T. pole N07E 15.85' (ex. 16d nail on W. side) #6
12" Scotch Pine N00E 19.02' (set 60d nail over ex. 16d nail on W. side)
11" Cherry N71W 55.34' (set 60d nail over ex. 16d nail on S. side) #8

Signed by [Signature] Date 8-10-2000
Surveyor's Michigan License No. 17634

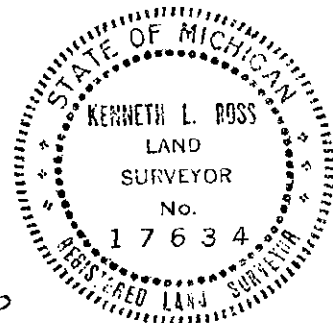

Approved by Peer Review Group on 8-10-2000
Kenneth L. Ross, County Representative [Signature]

FORM APPROVED BY MICHIGAN STATE BOARD OF LAND SURVEYORS, JAN. 28,

1971
REVISED MAY 14, 1976
REVISED JAN., 1983
ADAPTED FOR WORD PROCESSING MARCH, 1983