

**SURVEY &  
REMONUMENTATION**

**JAN 23 2001**

**SECTION**

**LAND CORNER RECORDATION CERTIFICATE**

Filing Requirement of Act 74, Mich. P.A. 1970

FILED  
AT 9:46 O'CLOCK A. M  
ALG 17 2000  
MARGARET KOLASKI ELLIOTT  
MASON COUNTY  
REGISTER OF DEEDS  
Register of Deeds Stamp & File Number

For corners In: Located In: Corner Code #

Mason County

- 1. Public Land Survey T18N R. 18W K-11  
T R  
T R  
T R
- 2. Property Controlling S T R  
in Section S T R
- 3. Miscellaneous S T R  
Property in Sec. S T R
- 4. Lot No. \_\_\_\_\_, Recorded Plat \_\_\_\_\_
- 5. Private Claims \_\_\_\_\_

I, Kenneth L. Ross in a field survey on July 25, 2000, Do hereby certify that under requirements of P.A.74, Michigan P.A. of 1970, the corner points mentioned in lines 1 and 2 above were in conformance with regulations and rules therefore as required in the current manual of survey instructions of the United States Department of the Interior, Bureau of Land Management or by a decree of a Court of Law and/or that the corner points mentioned in lines 3, 4 and 5 above were in conformance with the rules of the Michigan Board of Land Surveyors or by a Decree of a Court of Law; established, re-established, monumented, re-monumented, recovered, found as expressed below:

Section corner common to section 25, 26, 35 and 36 of T18N, R18W.

**A. Description of original monument and accessories and/or subsequent restoration:**

GLO Sibley 1839 set post  
12" Beech S26E 13 lks. (6.58') #1  
10" Beech N29E 30 lks. (19.80') #2

MCRC undated  
Iron  
Poplar 6" N56W 17' #3  
4" cherry NE .5' #4  
18" pine S35E 40.3' #5

Ross PLS 17634 Set cor. from Stephens Dwg. F129  
Unrecorded surveys 1976, 1979 & 1997  
Set 4" conc. mon.  
32" W. pine S40W 44.29' #6  
16" Maple N30W 40.12' #7  
16" Tw. Beech N80E 67.55' #8  
Small stream running N. Due E. 25'

Richard Hays PLS 25847  
L 378 P 291  
No witnesses or description

Bonney PLS 12016  
L 271 P 1 & L 271 P 108  
36" pine S36W 44.39' #6  
15" Maple N34W 40.04' #7  
10" Beech E. 67.96' #8

Hays PLS 25847 L305 P220  
Oct. 1982  
Conc. Mon.  
32" W. pine S40W 44.29' #6  
16" Maple N30W 40.12' #7  
16" Tw. Beech N80E 67.55' #8

Fluharty RLS 18223 L329 P 845  
August 1985  
Fd. Conc. mon.  
36" W. pine S36W 44.39' #6  
15" Maple N34W 40.04' #7  
28" Oak West 23.03' #8

	A	B	C	D	E	F	G	H	I	J	K	L	M
1													
2	6	5	4	3	2	1							
3													
4	7	8	9	10	11	12							
5													
6	18	17	16	15	14	13							
7													
8	19	20	21	22	23	24							
9													
10	30	29	28	27	26	25							
11													
12	31	32	33	34	35	36							
13													

**B. Description of corner evidence found and/or method applied in restoring or reestablishing corner:**

I found a 4" x 36" concrete monument.

The condition of the accessories is as follows: 1,2,3,4 and 5 are gone. 6,7, and 8 are in good condition.


I found nothing to dispute the location of this corner.

**C. Description of monument for corner and accessories established to perpetuate locating the position of the corner:**

I replaced the concrete monument with a Harrison Monument stamped "Mason County Monument PLS 17634. I accepted this as a careful and faithful reestablishment of the position of the original corner. There are no well defined occupation lines at this corner.

- 24" Beech N90E 67.26' (ex. 60d nail N. side) #8
- 14" W. Pine S10E 75.78' (set 60d nail on W. side)
- 40" W. Pine S38W 44.30' (set 60d nail on E. side) #6
- 24" R. Oak N31W 59.95' (set 60d nail on W. side)

Signed by [Signature] Date 8-10-2000  
Surveyor's Michigan License No. 17634

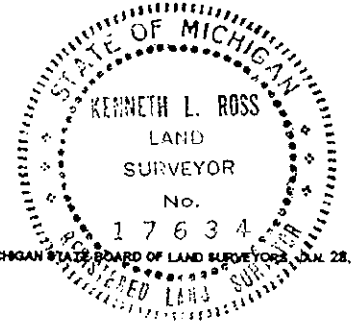

Approved by Peer Review Group on 8-22-2001  
Kenneth L. Ross, County Representative [Signature]

FORM APPROVED BY MICHIGAN STATE BOARD OF LAND SURVEYORS JUN. 28, 1971  
REVISED MAY 14, 1978  
REVISED JAN., 1983  
ADAPTED FOR WORD PROCESSING MARCH, 1993