

**SURVEY &
REMONUMENTATION**

JAN 23 2001

LAND CORNER RECORDATION CERTIFICATE

SECTION

Filing Requirement of Act 74, Mich. P.A. 1970

For corners In: Located In: Corner Code #
Mason County

1. Public Land Survey T 18N R 18W K-12
T R
T R
T R
2. Property Controlling S T R
in Section S T R
3. Miscellaneous S T R
Property in Sec. S T R
4. Lot No. _____, Recorded Plat _____
5. Private Claims _____

FILED
AT 9:45 O'CLOCK A. M.
AUG 17 2000
MARGARET KOLASKI ELLIOTT
MASON COUNTY
REGISTER OF DEEDS
Register of Deeds Stamp & File Number

	A	B	C	D	E	F	G	H	I	J	K	L	M
1													
2	6	5	4	3	2	1							
3													
4	7	8	9	10	11	12							
5													
6	18	17	16	15	14	13							
7													
8	19	20	21	22	23	24							
9													
10	30	29	28	27	26	25							
11													
12	31	32	33	34	35	36							
13													

I, Kenneth L. Ross in a field survey on July 25, 2000, Do hereby certify that under requirements of P.A.74, Michigan P.A. of 1970, the corner points mentioned in lines 1 and 2 above were in conformance with regulations and rules therefore as required in the current manual of survey instructions of the United States Department of the Interior, Bureau of Land Management or by a decree of a Court of Law and/or that the corner points mentioned in lines 3, 4 and 5 above were in conformance with the rules of the Michigan Board of Land Surveyors or by a Decree of a Court of Law; established, re-established, monumented, re-monumented, recovered, found as expressed below:

¼ corner common to sections 35 and 36 of T18N, R18W

A. Description of original monument and accessories and/or subsequent restoration:

- GLO Sibley 1838
40" pine * no witnesses
- McPherson RLS 12003
For Consumers Power L1 P64 1974
Fd. ¾" pipe
PP SW 56.79' #4
Rd. sign N38W 54.42' #5
10" Maple S66E 36.38' #6
also recorded LCRC 1975 L1 P274
- Hays RLS 25847 L378 P291
No witnesses or description
- MCRC undated
TP N31W 49.0 #1
Tel. Guy Pole S57 1/2W 44.5' #2
Maple 4" S59E 36.7' #3
- Stevens RLS 7318 for Consumers Power
in 1968 (same as above)
- Hooth RLS 7966 LCRC L1 P325
Fd. ¾" pipe w/PK nail within in mon. box
PP S50W 56.66' #4
Rd. sign post N30W 54.36' #5
14" Maple S60E 36.52' #6
7" pine N45E 65.61' #7
- Ross (unrecorded) 1976, 1979 & 1997
iron in mon. box no witnesses

B. Description of corner evidence found and/or method applied in restoring or reestablishing corner:

I found a ¾" x 24" galvanized pipe in a monument box in the center of N-S and road to the West.


The condition of the accessories are as follows: 1 and 2 are gone, 3 is good but nail is gone, 5 and 6 are good, and 7 is good but nail is gone. 4 is in good condition but pole appears to be tipped.

I found nothing to dispute the location of this corner.

C. Description of monument for corner and accessories established to perpetuate locating the position of the corner:

I set a 5/8" X 18" iron rod with a 2 ½" aluminum cap stamped "Mason County Monument PLS 17634", in the exact location of the ex. ¾" x 24" pipe in the monument box. I accepted this as a careful and faithful reestablishment of the position of the original corner.

Guy pole S43E 32.33' set mag. nail over ex. 60d nail on SW side
PP S48W 57.08' ex. 60d nail NW side #4
TW 9" locust N57E 47.39' set 60d nail NW side
NW cor. wood fr. garage S82E 136.84'

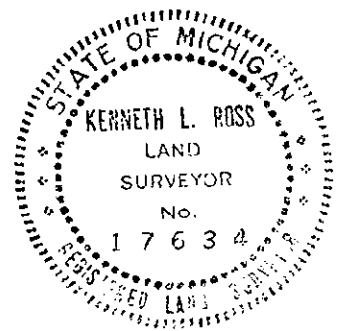

Signed by [Signature] Date 8-10-2000
Surveyor's Michigan License No. 17634

Approved by Peer Review Group on 8-10-2000
Kenneth L. Ross, County Representative [Signature]

FORM APPROVED BY MICHIGAN STATE BOARD OF LAND SURVEYORS, JAN. 28,
1971
REVISED MAY 14, 1976
REVISED JAN., 1985
ADAPTED FOR WORD PROCESSING MARCH, 1983