

SURVEY &  
REMONUMENTATION

MAR 08 1994

COMMISSION

LAND CORNER RECORDATION CERTIFICATE  
Filing Requirement of Act 74, Mich. P.A. 1970


For corners in  
MASON

(County)

Located In:

Corner Code:##

- |                                    |   |     |   |     |         |
|------------------------------------|---|-----|---|-----|---------|
| 1. Public Land Survey              | T | 18N | R | 18W | L-3 M-3 |
|                                    | T |     | R |     |         |
|                                    | T |     | R |     |         |
|                                    | T |     | R |     |         |
| 2. Property Controlling in Section | S |     | T | R   |         |
|                                    | S |     | T | R   |         |
| 3. Miscellaneous Property in Sec.  | S |     | T | R   |         |
|                                    | S |     | T | R   |         |

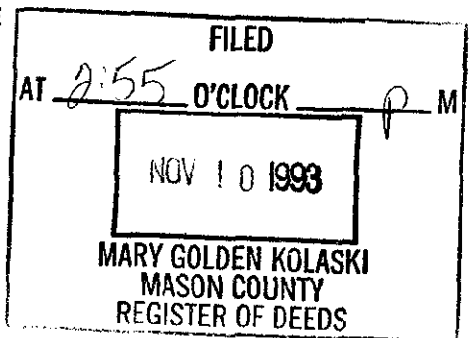

Register of Deeds Stamp & File Number

4. Lot No. \_\_\_\_\_, Recorded Plat \_\_\_\_\_  
5. Private Claims \_\_\_\_\_

I, Kenneth L. Ross, in a field survey on NOVEMBER, 19 93, do hereby certify that under requirements of P.A. 74, Michigan P.A. of 1970, the corner points mentioned in lines 1 and 2 above were in conformance with regulations and rules therefore as required in the current manual of survey instructions of the United States Department of the Interior, Bureau of Land Management or by a decree of a Court of Law and/or that the corner points mentioned in lines 3, 4 and 5 above were in conformance with the rules of the Michigan Board of Land Surveyors or by a Decree of a Court of Law; established, re-established, monumented, re-monumented, recovered, found as expressed below:

	A	B	C	D	E	F	G	H	I	J	K	L	M
2	6	5	4	3	2	1							
3													
4	7	8	9	10	11	12							
5													
6	18	17	16	15	14	13							
7													
8	19	20	21	22	23	24							
9													
10	30	29	28	27	26	25							
11													
12	31	32	33	34	35	36							
13													

**NOTE: Not more than 4 corners, all in the same town and range, may be recorded on this certificate.**

A. Description of original monument and accessories and/or subsequent restoration:

- |   |   |
|---|---|
| L-3 1/4 Corner, Secs. 1 & 12<br>1838 Sylvester Sibley set Post<br>8" Beech N 4 W 12 lks<br>6" Beech S 33 E 7 lks | M-3 Section Corner, 1 & 12, 18-18; 6 & 7, 18-17<br>1838 Sylvester Sibley set Post<br>24" Beech for corner<br>no witness |
|---|---|

B. Description of corner evidence found and/or method applied in restoring or reestablishing corner:

- |   |   |
|---|---|
| L-3 1/4 Corner, Secs. 1 & 12<br>1888 J. A. Mitchell corner in swamp could not be found in edge of water platted new corner 1.73 East of Hemlock 8" diameter on west margin of bayou and subdivided section no witness<br>1961 Blass Mason Co. Airport survey used corner<br>1974 Barnett Fd 1" pipe<br>8" Cedar N 52 E 50.65'<br>8" Twin Birch S 10 W 66.57'<br>6" Birch West 68.17'<br>(spikes in above trees for identification)<br>1993 Ross used corner | M-3 Section Corner, 1 & 12, 18-18; 6 & 7, 18-17<br>1888 J. A. Mitchell planted stake and subdivided section no witness<br>1946 Lunde used corner no witness<br>1961 Blass Mason Co. Airport survey used corner<br>1979 Dunlap Fd Iron rod in fence corner no witness<br>1983 Ross Fd 5/8" threaded rod no witness<br>1993 Ross Fd 5/8" Iron rod in fence corner<br>no witness |
|---|---|

C. Description of monument for corner and accessories established to perpetuate locating the position of the corner:

- |   |   |
|---|---|
| L-3 1/4 Corner, Secs. 1 & 12<br>Found Ross capped Iron, replaced with Mason Co. monument with 2 1/2" alum. cap, and is accepted as the best available evidence of the original corner.<br>Metal Fence Post East 2.52'<br>11" Maple S 47 E 64.83'<br>10" Cedar N 83 E 50.67'<br>14" R. Pine N 43 E 78.90'<br>3" W. Pine S 61 W 81.00' | M-3 Section Corner, 1 & 12, 18-18; 6 & 7, 18-17<br>Found existing 5/8" threaded rod in center of pile of 5" +/- diameter rocks, placed 2 1/2" alum. cap on top of threaded rod, and is accepted as the best available evidence of the original corner.<br>24" Ash N 21 E 16.36'<br>10" Tri Ash N 68 E 22.65'<br>8" Tw. Ash S 82 E 20.73'<br>8" Ash S 07 E 23.29'<br>Old Fence East - N & S |
|---|---|

Signed by Kenneth L. Ross  
Surveyor's Michigan License No. 17634

Date Nov 9, 1993

