

**SURVEY &  
REMONUMENTATION**

MAR 08 1994

**COMMISSION**

**LAND CORNER RECORDATION CERTIFICATE**  
Filing Requirement of Act 74, Mich. P.A. 1970


For corners in  
MASON

(County)

Located In:

Corner Code #

- |                                    |   |     |   |     |      |
|------------------------------------|---|-----|---|-----|------|
| 1. Public Land Survey              | T | 18N | R | 18W | L-5, |
|                                    | T |     | R |     |      |
|                                    | T |     | R |     |      |
|                                    | T |     | R |     |      |
| 2. Property Controlling in Section | S |     | T | R   |      |
|                                    | S |     | T | R   |      |
| 3. Miscellaneous Property in Sec.  | S |     | T | R   |      |
|                                    | S |     | T | R   |      |

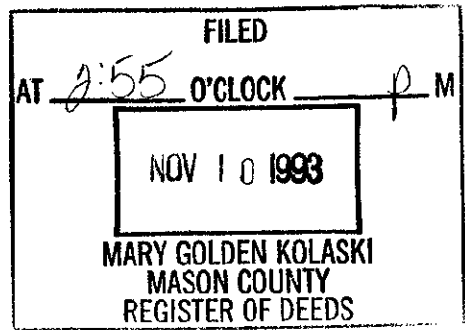

Register of Deeds Stamp & File Number

4. Lot No. \_\_\_\_\_, Recorded Plat \_\_\_\_\_  
5. Private Claims \_\_\_\_\_

I, Kenneth L. Ross, in a field survey on NOVEMBER, 1993, do hereby certify that under requirements of P.A. 74, Michigan P.A. of 1970, the corner points mentioned in lines 1 and 2 above were in conformance with regulations and rules therefore as required in the current manual of survey instructions of the United States Department of the Interior, Bureau of Land Management or by a decree of a Court of Law and/or that the corner points mentioned in lines 3, 4 and 5 above were in conformance with the rules of the Michigan Board of Land Surveyors or by a Decree of a Court of Law; established, re-established, monumented, re-monumented, recovered, found as expressed below:

	A	B	C	D	E	F	G	H	I	J	K	L	M
2	6		5		4		3		2		1		
3													
4	7		8		9		10		11		12		
5													
6	18		17		16		15		14		13		
7													
8	19		20		21		22		23		24		
9													
10	30		29		28		27		26		25		
11													
12	31		32		33		34		35		36		
13													

**NOTE: Not more than 4 corners, all in the same town and range, may be recorded on this certificate.**

A. Description of original monument and accessories and/or subsequent restoration:


- L-5 1/4 Corner, Secs. 12 & 13
- 1838 Sylvester Sibley set Post
- 6" Pine S 32 W 27 lks
- 6" Pine N 3 E 25 lks

B. Description of corner evidence found and/or method applied in restoring or reestablishing corner:

- L-5 1/4 Corner, Secs. 12 & 13
- 1888 J. A. Mitchell planted Iron 1" square X 20" length at site of old corner and subdivided section no witness
- 1961 Blass Mason Co. Airport survey used corner
- 1978 Hooth Fd corner, filed Act 74
- took 3 witness
- 6" W. Cherry N 80 E 47.08'
- 6" W. Birch N 50 E 39.50' 2" Maple N 30 W 24.68'
- 7' N. to ditch F.S. 21' S. to ditch F.S. on abandoned, non-traveled E.W. Johnson Rd.
- corner destroyed due to pipe line construction by Dow, reset from traverse information by Blass of 1961 no witness

C. Description of monument for corner and accessories established to perpetuate locating the position of the corner:

- L-5 1/4 Corner, Secs. 12 & 13
- Found 1/2" capped Iron with Ross cap (17634) along North edge of airport on extension of Johnson rd., replaced with 5/8" X 36" re-bar with 2 1/2" alum. cap set flush with ground, and is accepted as the best available evidence of the original corner.
- West log airport beacon light 3rd bolt from ground S 04 W 308.27'
- Wood antenna support pole S 50 E 275.24'
- 8" Tri Maple N 29 W 23.85'
- 10" Cherry N 65 E 40.07' Johnson Road East 319'+
- 1" Iron pipe North 32.03'

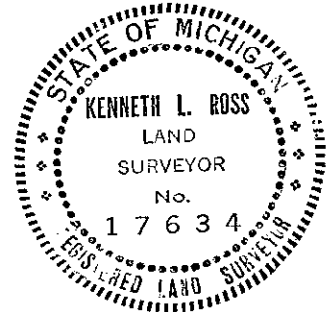

Signed by Kenneth L. Ross Date Nov. 9, 1993

Surveyor's Michigan License No. 17634 Peer Group Reviewed and Approved

Date: 11-9-93  
Kenneth L. Ross  
Mason County Surveyor