

SURVEY & REMONUMENTATION

JAN 23 2001

LAND CORNER RECORDATION CERTIFICATE Filing Requirement of Act 74, Mich. P.A. 1970

SECTION

For corners In: Located In: Corner Code #

Mason County

- | | | | |
|---------------------------------------|-------------------------|-------|-------|
| 1. Public Land Survey | T 18N R 18W | L-13 | |
| | T _____ R _____ | _____ | _____ |
| | T _____ R _____ | _____ | _____ |
| | T _____ R _____ | _____ | _____ |
| 2. Property Controlling in Section | S _____ T _____ R _____ | _____ | _____ |
| | S _____ T _____ R _____ | _____ | _____ |
| 3. Miscellaneous Property in Sec. | S _____ T _____ R _____ | _____ | _____ |
| | S _____ T _____ R _____ | _____ | _____ |
| 4. Lot No. _____, Recorded Plat _____ | | | |
| 5. Private Claims _____ | | | |

FILED

AT 9:44 O'CLOCK A. M

AUG 1 2000

MARGARET KOLASKI ELLIOTT
MASON COUNTY
REGISTER OF DEEDS

Register of Deeds Stamp & File Number

	A	B	C	D	E	F	G	H	I	J	K	L	M
1													
2	6	5	4	3	2	1							
3													
4	7	8	9	10	11	12							
5													
6	18	17	16	15	14	13							
7													
8	19	20	21	22	23	24							
9													
10	30	29	28	27	26	25							
11													
12	31	32	33	34	35	36							
13													

I, Kenneth L. Ross in a field survey on June 20, 2000, Do hereby certify that under requirements of P.A. 74, Michigan P.A. of 1970, the corner points mentioned in lines 1 and 2 above were in conformance with regulations and rules therefore as required in the current manual of survey instructions of the United States Department of the Interior, Bureau of Land Management or by a decree of a Court of Law and/or that the corner points mentioned in lines 3, 4 and 5 above were in conformance with the rules of the Michigan Board of Land Surveyors or by a Decree of a Court of Law; established, re-established, monumented, re-monumented, recovered, found as expressed below:

South quarter corner of section 36 of T18N, R18W.

A. Description of original monument and accessories and/or subsequent restoration:

- | | | |
|--|--|---|
| GLO Mullett & Brookfield 1838 set post
12" Beech N50W 4 lks. (2.64') #1
12" Beech N6E 33 lks. (21.78') #2 | Fluharty RLS 18223 L342 P 81
5-2-86
Fd. 1" pipe in mon. box
Light pole S11E 21.58' #9
PP N29E 112.07' #10
PP N10W 141.08' #11 | MDOT (undated)
3/4" iron pipe in mon. box in Cen. of Chauvez Rd.
PP N10W 141.06' #11
G. post S65W 45.06' #8
G. post S45W 25.20' #10
G. post S20E 21.09' #6 |
| MCRC 1958
4" pine N35E 50.65' #3
Rd. sign N50E 43.70' #4
PP N10W 140.89' #5 | Ross RLS 17634 unrecorded survey 1998
Fd. iron in mon. box
No witness taken. | Stephens RLS 7318 for Consumers Power Co. 1968
Found 1" pipe
4" pine N35E 50.65' #3
PP N10W 140.89' #13
Rd. sign N50E 43.70' #14 |
| MCRC 1970 (J. Borsfay)
"Two corners are lost at construction after construction, reset and wit."
Last Guard post S. side SE 20.72' #6
4" guard post South S. SW 35.33' #7
Last guard post N. side NW 45.22' #8 | Dunlap RLS May 1983
L302 P143
No identification or witnesses | |

B. Description of corner evidence found and/or method applied in restoring or reestablishing corner:


I found a 3/4" X 9" iron pipe in a monument box in the centerline of E-W rd. and 4' West of the centerline of a rd. to the North.
 The condition of the accessories are as follows: 1,2,3,4,5, are gone. 6, 7 and 8 are good but no nails, 11, 12 and 13 are in good condition.
 I found nothing to dispute the location of this corner.

C. Description of monument for corner and accessories established to perpetuate locating the position of the corner:

I replaced the 3/4" X 9" iron pipe with a 5/8" x 18" iron rod w/aluminum cap stamped "Mason County Monument PLS 17634". I accepted this as a careful and faithful reestablishment of the position of the original corner.

- Street light pole S12E 21.68' (MSHD shiner & 16d nail on E. side)
- Power pole N63E 70.59' (set mag. nail on N. side)
- NW corner of House N44E 129.70'
- Most Easterly Guard rail on N side rd. N62W 45.35' (set 60d spike on S. side)
- N 1/4 corner for section 1 of T17N, R18W is East 13.72'
- Distance to M-13 of T18N, R18W is East 2656.08'

Signed by *Kenneth L. Ross* Date 8-10-2000
 Surveyor's Michigan License No. 17634

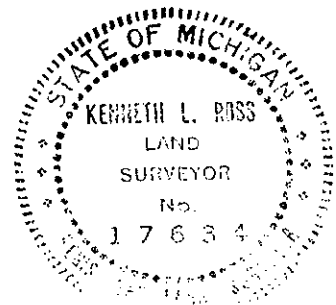

Approved by Peer Review Group on 8-10-2000
 Kenneth L. Ross, County Representative *[Signature]*

FORM APPROVED BY MICHIGAN STATE BOARD OF LAND SURVEYORS, JAN. 23,
 1971
 REVISED MAY 14, 1978
 REVISED JAN, 1982
 ADAPTED FOR WORD PROCESSING MARCH, 1993