

SURVEY &
REMONUMENTATION

MAR 08 1994

COMMISSION

LAND CORNER RECORDATION CERTIFICATE
Filing Requirement of Act 74, Mich. P.A. 1970


For corners in
MASON

(County)

Located In:

Corner Code #

- | | | | | | |
|---------------------------------------|---|-----|---|-----|-----|
| 1. Public Land Survey | T | 18N | R | 18W | M-5 |
| | T | | R | | |
| | T | | R | | |
| | T | | R | | |
| 2. Property Controlling
in Section | S | | T | R | |
| | S | | T | R | |
| 3. Miscellaneous
Property in Sec. | S | | T | R | |
| | S | | T | R | |
4. Lot No. _____, Recorded Plat _____
5. Private Claims _____

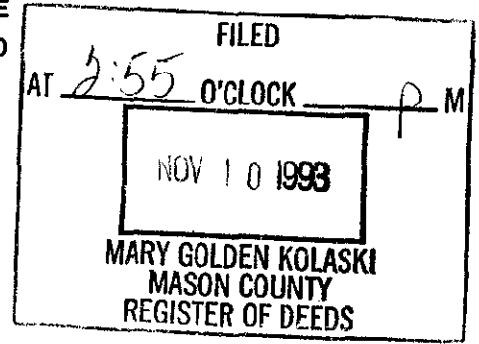

Register of Deeds Stamp & File Number

I, Kenneth L. Ross, in a field survey on NOVEMBER, 1993, do hereby certify that under requirements of P.A. 74, Michigan P.A. of 1970, the corner points mentioned in lines 1 and 2 above were in conformance with regulations and rules therefore as required in the current manual of survey instructions of the United States Department of the Interior, Bureau of Land Management or by a decree of a Court of Law and/or that the corner points mentioned in lines 3, 4 and 5 above were in conformance with the rules of the Michigan Board of Land Surveyors or by a Decree of a Court of Law; established, re-established, monumented, re-monumented, recovered, found as expressed below:

	A	B	C	D	E	F	G	H	I	J	K	L	M
2	6	5	4	3	2	1							
3													
4	7	8	9	10	11	12							
5													
6	18	17	16	15	14	13							
7													
8	19	20	21	22	23	24							
9													
10	30	29	28	27	26	25							
11													
12	31	32	33	34	35	36							
13													

NOTE: Not more than 4 corners, all in the same town and range, may be recorded on this certificate.

A. Description of original monument and accessories and/or subsequent restoration:

- | | |
|---|--|
| M-4 1/4 Corner, Secs. 12-18-18 & 7-18-17
1838 Sylvester Sibley set Post
8" Beech N 8 W 8 lks
10" Maple S 45 W 26 lks | M-5 Section Corner, Secs. 12 & 13, 18-18; 7 & 18, 18-17
1838 Mullett & Brookfield set Post
8" Pine N 12 W 16 lks
6" Maple S 20 W 35 lks |
|---|--|


B. Description of corner evidence found and/or method applied in restoring or reestablishing corner:

- | | |
|---|--|
| M-4 1/4 Corner, Secs. 12-18-18 & 7-18-17
1888 J. A. Mitchell planted stake by measurement nothing found and subdivided section no witness
1916 C. E. Mitchell used corner in subdivision of section 7-18-17 Mason Co. Records Page 197 & 198
1961 Blass Mason Co. Airport survey set "T" Iron
1974 Ross Fd "T" Iron
P. Pole N 80 E 32.45'
Tw. 6" Wild Cherry S 20 W 55.89'
8" Norway Pine N 20 E 34.50'
1979 Dunlap Fd corner no witness
1983 Ross set 1/2" Iron from witness
Tele. Pole N 80 W 31.62' P. Pole S 80 E 29.63'
Clump of 3-4" Birch N 20 W 53.30' | M-5 Section Corner, Secs. 12 & 13, 18-18; 7 & 18, 18-17
1888 J. A. Mitchell placed stake from old witness and subdivided section no witness
1916 C. E. Mitchell used corner in subdivision of section 7-18-17 Mason Co. Records Page 197 & 198
1961 Blass Mason Co. Airport survey used corner
1962 Stephens used 1/2" pipe for corner no witness.
1974 Ross Fd 1" pipe in center line of E-W road
4' West of N-S road
P. Pole N 50 E 45.73'
8" W. Pine S 60 E 77.47'
Cor. Fence Post S 50 W 44.14' |
|---|--|

C. Description of monument for corner and accessories established to perpetuate locating the position of the corner:

- | | |
|---|---|
| M-4 1/4 Corner, Secs. 12-18-18 & 7-18-17
Found existing 1/2" capped Iron Ross (17634) in pavement 2.0' West of center line of Meyers road, replaced with monument box with 5/8" X 24" Iron with 2 1/2" alum. cap, and is accepted as the best available evidence of the original corner.
P. Pole S 68 E 29.66'
P. Pole N 65 W 31.37'
SW Cor. Pole Barn N 79 E 115.43'
16" Elm S 15 W 102.02' | M-5 Section Corner, Secs. 12 & 13, 18-18; 7 & 18, 18-17
Found existing 1 1/4" pipe, drove 5/8" X 36" re-bar with 2 1/2" alum. cap inside 1 1/4" pipe, and is accepted as the best available evidence of the original corner.
W 1/4 Cor. 7-18-17 N 00 E 2638.65'
S 1/4 Cor. 7-18-17 N 89-04-05 E 2528.01'
W 1/4 Cor. 18-18-17 S 08-18-05 E 2947.62'
S 1/4 Cor. 12-18-18 S 89-51-15 W 2637.08'
West 8" X 2' High White Post N 03-53 W 187.16'
8" W. Pine N 13-21-50 E 541.60'
Dow Buried Cable Post S 57-26-05 E 23.63'
Date <u>Nov. 9, 1993</u> |
|---|---|

Signed by Kenneth L. Ross
Surveyor's Michigan License No. 17634

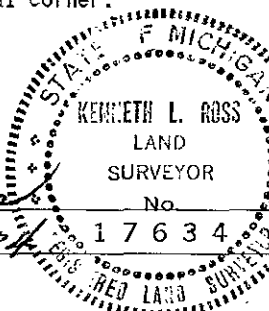

LIBER 3 PAGE 167

FORM APPROVED BY MICHIGAN STATE BOARD OF LAND SURVEYORS, JAN. 28, 1971
Peer Group Reviewed and Approved
REVISOR MAY 14, 1975
REVISED JAN., 1983

Date: 11-9-93
Kenneth L. Ross