

MAR 08 1994

COMMISSION


LAND CORNER RECORDATION CERTIFICATE
Filing Requirement of Act 74, Mich. P.A. 1970

For corners in MASON (County)

Located In:

Corner Code ##

Table with 3 columns: Item description (Public Land Survey, Property Controlling, etc.), Township/Range/Section (T 18N R 18W), and Corner Code (M-4, M-5).

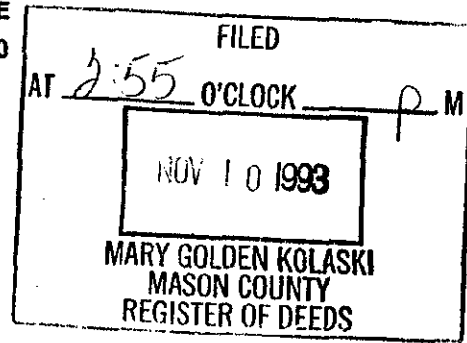

Register of Deeds Stamp & File Number

4. Lot No. , Recorded Plat
5. Private Claims

I, Kenneth L. Ross, in a field survey on NOVEMBER, 19 93, do hereby certify that under requirements of P.A. 74, Michigan P.A. of 1970, the corner points mentioned in lines 1 and 2 above were in conformance with regulations and rules therefore as required in the current manual of survey instructions of the United States Department of the Interior, Bureau of Land Management or by a decree of a Court of Law and/or that the corner points mentioned in lines 3, 4 and 5 above were in conformance with the rules of the Michigan Board of Land Surveyors or by a Decree of a Court of Law; established, re-established, monumented, re-monumented, recovered, found as expressed below:

NOTE: Not more than 4 corners, all in the same town and range, may be recorded on this certificate.

A. Description of original monument and accessories and/or subsequent restoration:

- M-4 1/4 Corner, Secs. 12-18-18 & 7-18-17: 1838 Sylvester Sibley set Post, 8" Beech N 8 W 8 lks, 10" Maple S 45 W 26 lks.
M-5 Section Corner, Secs. 12 & 13, 18-18; 7 & 18, 18-17: 1838 Mullett & Brookfield set Post, 8" Pine N 12 W 16 lks, 6" Maple S 20 W 35 lks.


B. Description of corner evidence found and/or method applied in restoring or reestablishing corner:

- M-4 1/4 Corner, Secs. 12-18-18 & 7-18-17: 1888 J. A. Mitchell planted stake by measurement, 1916 C. E. Mitchell used corner in subdivision of section 7-18-17 Mason Co. Records Page 197 & 198, 1961 Blass Mason Co. Airport survey set "T" Iron, 1974 Ross Fd "T" Iron, P. Pole N 80 E 32.45', Tw. 6" Wild Cherry S 20 W 55.89', 8" Norway Pine N 20 E 34.50', 1979 Dunlap Fd corner no witness, 1983 Ross set 1/2" Iron from witness, Tele. Pole N 80 W 31.62' P. Pole S 80 E 29.63', Clump of 3-4" Birch N 20 W 53.30'.
M-5 Section Corner, Secs. 12 & 13, 18-18; 7 & 18, 18-17: 1888 J. A. Mitchell placed stake from old witness and subdivided section no witness, 1916 C. E. Mitchell used corner in subdivision of section 7-18-17 Mason Co. Records Page 197 & 198, 1961 Blass Mason Co. Airport survey used corner, 1962 Stephens used 1/2" pipe for corner no witness, 1974 Ross Fd 1" pipe in center line of E-W road, 4' West of N-S road, P. Pole N 50 E 45.73', 8" W. Pine S 60 E 77.47', Cor. Fence Post S 50 W 44.14'.

C. Description of monument for corner and accessories established to perpetuate locating the position of the corner:

- M-4 1/4 Corner, Secs. 12-18-18 & 7-18-17: Found existing 1/2" capped Iron Ross (17634) in pavement 2.0' West of center line of Meyers road, replaced with monument box with 5/8" X 24" Iron with 2 1/2" alum. cap, and is accepted as the best available evidence of the original corner. P. Pole S 68 E 29.66', P. Pole N 65 W 31.37', SW Cor. Pole Barn N 79 E 115.43', 16" Elm S 15 W 102.02'.
M-5 Section Corner, Secs. 12 & 13, 18-18; 7 & 18, 18-17: Found existing 1 1/4" pipe, drove 5/8" X 36" re-bar with 2 1/2" alum. cap inside 1 1/4" pipe, and is accepted as the best available evidence of the original corner. W 1/4 Cor. 7-18-17 N 00 E 2638.65', S 1/4 Cor. 7-18-17 N 89-04-05 E 2528.01', W 1/4 Cor. 18-18-17 S 08-18-05 E 2947.62', S 1/4 Cor. 12-18-18 S 89-51-15 W 2637.08', West 8" X 2' High White Post N 03-53 W 187.16', 8" W. Pine N 13-21-50 E 541.60', Dow Buried Cable Post S 57-26-05 E 23.63', Date NOV. 9, 1993.

Signed by Kenneth L. Ross
Surveyor's Michigan License No. 17634

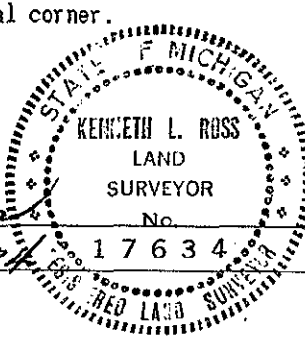

LIBER 3 PAGE 167

Date: 11-9-93
Kenneth L. Ross