

**SURVEY &
REMONUMENTATION**


MAR 16 1998

JUL 23 1997

LAND CORNER RECORDATION CERTIFICATE
Filing Requirement of Act 74, Mich. P.A. 1970

SECTION
For corners in

MASON (County) Located In: Corner Code #
 1. Public Land Survey T 18N R 18W L-1
 T _____ R _____
 T _____ R _____
 T _____ R _____
 2. Property Controlling S _____ T _____ R _____
 In Section S _____ T _____ R _____
 3. Miscellaneous S _____ T _____ R _____
 Property In Sec. S _____ T _____ R _____

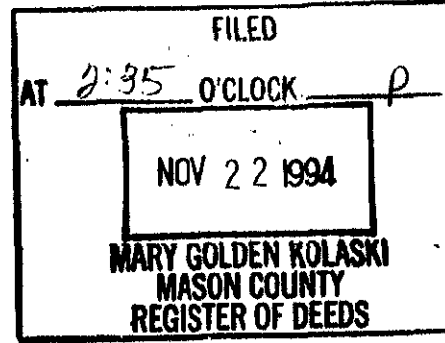

Register of Deeds Stamp & File Number

4. Lot No. _____, Recorded Plat _____
 5. Private Claims _____

	A	B	C	D	E	F	G	H	I	J	K	L	M
2	6		5		4		3		2		1		
3													
4	7		8		9		10		11		12		
5													
6	13		17		16		15		14		13		
7													
8	19		20		21		22		23		24		
9													
10	30		29		28		27		26		25		
11													
12	31		32		33		34		35		36		
13													

I, Theodore H. Weinert in a field survey on OCTOBER 1994, do hereby certify that under requirements of P.A. 74, Michigan P.A. of 1970, the corner points mentioned in lines 1 and 2 above were in conformance with regulations and rules therefore as required in the current manual of survey instructions of the United States Department of the Interior, Bureau of Land Management or by a decree of a Court of Law and/or that the corner points mentioned in lines 3, 4 and 5 above were in conformance with the rules of the Michigan Board of Land Surveyors or by a Decree of a Court of Law; established, re-established, monumented, re-monumented, recovered, found as expressed below:

NOTE: Not more than 4 corners, all in the same town and range, may be recorded on this certificate.

A. Description of original monument and accessories and/or subsequent restoration:


L-1 1/4 Corner, Sec. 1
 Corner not set during original government survey December, 1894, and April 7 & 8, 1895, J. A. Mitchell tied into corner without stating what was found (Book 1, Page 285 & Book 1, Page 287)

B. Description of corner evidence found and/or method applied in restoring or reestablishing corner:

L-1 1/4 Corner, Sec. 1
 Found 1" Pipe ID at corner location.
 S 1/4 Sec. 36, T19N, R18W, 4.58' West.
 Matched distance as called by J. A. Mitchell within 1.83' long from the west and 8.35' long from the east.
 This corner location is accepted as a careful and faithful perpetuation of the original corner.

C. Description of monument for corner and accessories established to perpetuate locating the position of the corner:

L-1 1/4 Corner, Sec. 1
 Set 5/8" X 24" rebar inside 1" ID pipe as found with standard 2 1/2" cap stamped "Mason County Remonumentation".
 8" Maple N 72 E 47.61'
 12" Maple S 37 E 33.70'
 18" Maple S 43 W 22.92'
 On CL Decker Road
 S 1/4 Corner Section 36, T19N, R18W, West 4.58'

 

Peer Group Reviewed and approved
 Date: Feb 23 1998
 Kenneth L. Ross
 Mason County Surveyor

Signed by Theodore H. Weinert

Date 11/6/99

Surveyor's Michigan License No. 19846

Peer Group Reviewed and Approved

Date: 11-7-99
 Kenneth L. Ross