


STATE OF MICHIGAN
DEPARTMENT
OF
NATURAL RESOURCES

LAND CORNER RECORD

MASON COUNTY
T 19 N R 18 W

DESCRIPTION OF CORNER SE corner, Section 20
CORNER MONUMENT Set DNR Monument & Post
DATE MONUMENT PLACED AND WITNESSED 11-12-71
WITNESSES TO CORNER..... 9" R. Oak N 13 E 11.8'

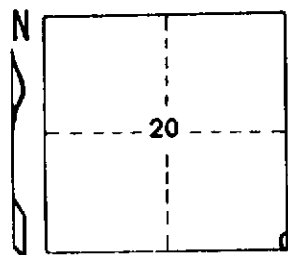


8" R. Oak S 68 E 21.4'
10" Tw. R. Oak S 45 W 10.6'
AND

CIRCLE CORNER REGISTERED

DESCRIPTION IN DETAIL AS TO HOW CORNER WAS LOCATED AND IDENTIFIED OR RESTORED.

Found 1 1/4" pipe and "T" fence post at corner. Previously located by Bob Lunde, Mason County Engineer, and used in local surveys. Best available evidence.

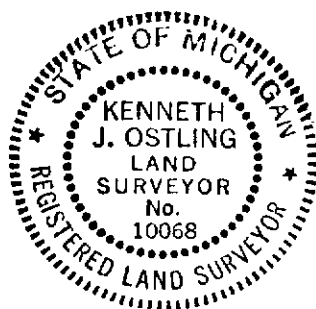

SURVEYOR'S SEAL

SIGNED

Kenneth J. Ostling
REGISTERED LAND SURVEYOR
10068

DATE 11-19-71

DISTRIBUTION:

County Courthouse
Area Forester (Regions I & II)
District or Region Surveyor
Forestry Div., Lansing

R 4047
Rev. 10/68