

STATE OF MICHIGAN
DEPARTMENT
OF
NATURAL RESOURCES

LAND CORNER RECORD


MASON COUNTY
T 19 N R 18 W

DESCRIPTION OF CORNER S W Corner, Section 17

CORNER MONUMENT Set DNR Monument & Post

DATE MONUMENT PLACED AND WITNESSED 11-18-71

WITNESSES TO CORNER..... Nail in 24" R. Oak N 45 W 25.5'

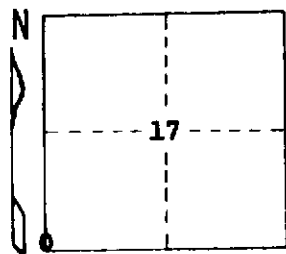

Nail in 10" Cedar N 50 E 23.6'


Nail in 8" Cedar S 13 E 12.1'

AND

CIRCLE CORNER REGISTERED

DESCRIPTION IN DETAIL AS TO HOW CORNER WAS LOCATED AND IDENTIFIED OR RESTORED.

This corner restored on line and double distant from 1/4 and section corner North.
Falls within 2' of position prescribed by 1930s Highway survey data.

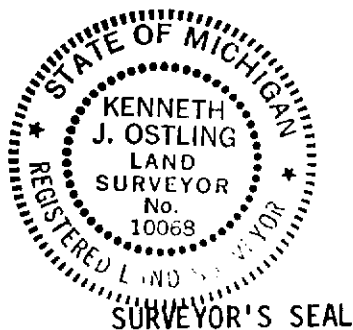

SURVEYOR'S SEAL

SIGNED

Kenneth J. Ostling
REGISTERED LAND SURVEYOR #10068

DATE

11-18-71

DISTRIBUTION:

County Courthouse
Area Forester (Regions I & II)
District or Region Surveyor
Forestry Div., Lansing

R 4047
Rev. 10/68