


STATE OF MICHIGAN
DEPARTMENT
OF
NATURAL RESOURCES

LAND CORNER RECORD

MASON COUNTY
T 19 N R 18 W

DESCRIPTION OF CORNER W 1/4 Section 17
CORNER MONUMENT Set DNR monument & post
DATE MONUMENT PLACED AND WITNESSED 11-11-71
WITNESSES TO CORNER..... 10" S. Maple S 25 W 9.9'

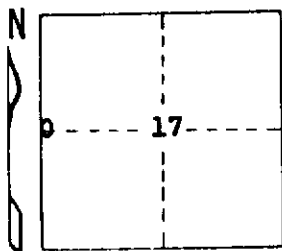


9" Hemlock N 50 W 9.9'
Old NBT 16" Beech N 53 E 5.4'
AND
Old NBT 20" Beech S 33 E 14.0'

CIRCLE CORNER REGISTERED

DESCRIPTION IN DETAIL AS TO HOW CORNER WAS LOCATED AND IDENTIFIED OR RESTORED.

Found 1" pipe at corner, as previously established by unknown surveyor. Two very old NBTs facing corner. Appears to have been located consistent with section corners North and South.

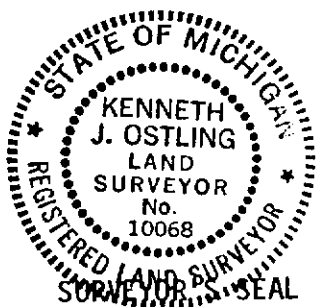

SIGNED

Kenneth Ostling
REGISTERED LAND SURVEYOR #10068

DATE

11-18-71

DISTRIBUTION:

County Courthouse
Area Forester (Regions I & II)
District or Region Surveyor
Forestry Div., Lansing

R 4047
Rev. 10/68