

LAND CORNER RECORDATION CERTIFICATE

FILING REQUIREMENT OF ACT 74, MICH. P.A.1970

| FOR CORNERS OF--: | LOCATED IN--: | CORNER CODE NUMBER |
|--|--------------------------------|--------------------|
| 1. PUBLIC LAND SURVEY _____ | T. _____ N. S., R. _____ E. W. | _____ |
| 2. PROPERTY CONTROLLING IN SECTION _____ | 29, T. 19 N. R. 18 | 16 |
| 3. MISCELLANEOUS PROPERTY IN SECTION _____ | 29, T. 19 N. R. 18 | 6; 2/D-9; 5/6 |
| 4. LOT NO. _____, RECORDED PLAT _____ | | |
| 5. PRIVATE CLAIMS _____ | | |

REGISTER OF DEEDS STAMP AND FILING NUMBER

I, Kenneth J. Ostling do hereby certify that under requirements of P.A. 74, Michigan P.A. of 1970 the corner points mentioned in lines 1 and 2 above (identified with circles on index code diagram—over) were, in field survey on August 29, 1974, established, re-established, monumented, re-monumented, recovered or restored as expressed below and in conformance with regulations and rules therefore as required in the current manual of survey instructions of the United States Department of the Interior, Bureau of Land Management or by a decree of court of law. Furthermore, that the corner points mentioned in lines 3, 4 and 5 above were, in a field survey on _____ 19____, found, recovered, restored, established or re-established as expressed below and in conformance with the rules of the Michigan State Board of Registration for Land Surveyors or, by a Decree of a Court of law:

~~A. Description of original monument and accessories and/or subsequent restorations~~

C. (continued)

5/6
1"x6' pipe & cedar post
w/location tag
J. Pine N15°E 11.69
J. Pine N82°W 15.83
J. Pine S58°E 17.21


- B. Description of corner evidence found and/or method applied in restoring or re-establishing corner:
- 16 Set by standard survey procedure for the subdivision of sections.
 - 6 Set by standard survey procedure for the subdivision of sections.
 - 2/D-9 Set to mark property boundary, by standard survey procedure.
 - 5/6 Set to mark property boundary, by standard survey procedure.

C. Description of monument for corner and accessories established to perpetuate locating the position of the corner

| 16 | 6 | 2/D-9 |
|---|--|--|
| Set 1"x42" pipe & cedar post w/location tag | 1"x6' pipe & cedar post w/location tag | Set 1"x6' pipe & cedar post w/location tag |
| 1½" Pipe Due W 29.0' | 6" J. Pine S65°W 57.35' | 11" J. Pine N40°W 8.82 |
| 3" J. Pine S12°W 63.72' | 8" J. Pine S21°E 100.00' | 7" J. Pine N40°E 39.24 |
| 3" J. Pine S30°E 77.16' | | |

SIGNED BY Kenneth J. Ostling
SURVEYOR'S MICHIGAN REGISTRATION NO. 10068

DATE 8-24-74

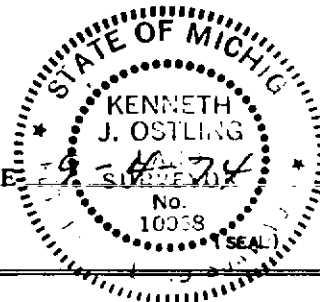

FOR STATE AND UNITED STATES AGENCIES:

SIGNED BY _____ DATE _____
CHIEF OF SURVEY PARTY

APPROVED AND SIGNED BY _____ DATE _____
MICHIGAN REGISTERED LAND SURVEYOR

(SEAL)

SURVEYOR'S MICHIGAN REGISTRATION NO. _____ MASON COUNTY