


DEC 18 1995

COMMISSION

LAND CORNER RECORDATION CERTIFICATE

Filing Requirement of Act 74, Mich. P.A. 1970

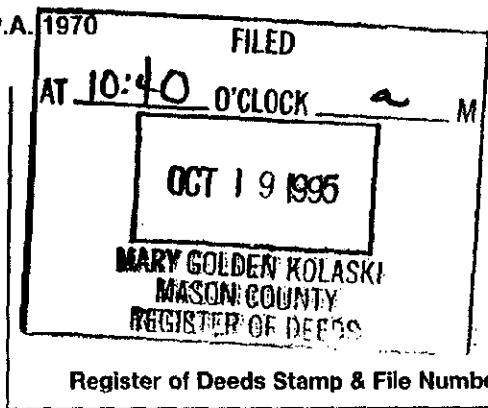

For corners in Mason (County) Located In: Corner Code #

1. Public Land Survey	T <u>19N</u> R <u>18W</u>	<u>H-7</u>
	T _____ R _____	_____
	T _____ R _____	_____
	T _____ R _____	_____
2. Property Controlling in Section	S _____ T _____ R _____	_____
	S _____ T _____ R _____	_____
3. Miscellaneous Property in Section	S _____ T _____ R _____	_____
	S _____ T _____ R _____	_____

4. Lot No. _____, Recorded Plat _____
 5. Private Claims _____

I, Richard Hays, in a field survey on September, 1995, do hereby certify that under requirements of P.A. 74, Michigan P.A. of 1970, the corner points mentioned in lines 1 and 2 above were in conformance with regulations and rules therefore as required in the current manual of survey instructions of the United States Department of the Interior, Bureau of Land Management or by a decree of a Court of Law and/or that the corner points mentioned in lines 3, 4 and 5 above were in conformance with the rules of the Michigan Board of Professional Surveyors or by a Decree of a Court of Law; established, re-established, monumented, re-monumented, recovered, found as expressed below:

NOTE: Not more than 4 corners, all in the same town and range, may be recorded on this certificate.

A. Description of original monument and accessories and/or subsequent restoration:

H-7 QUARTER CORNER FOR SECTIONS 15 & 22, T19N, R18W

1838 G.L.O. Sibley 1971 M.C.R.C. Found Concrete Monument 1957 Survey by Kenneth Stephons Replaced existing Pipe with concrete monument.

1) 16" Beech S-30°-W 19 3) Cherry West 29.40'
 2) 8" Hemlock N-23°-E 24 4) 10" Apple SE 23.35'
 5) P.Pole NW 44.40'

1901 Robert O. Towns
 found Stake and #2
 no new Witness

B. Description of corner evidence found and/or method applied in restoring or reestablishing corner:

H-7 QUARTER CORNER FOR SECTION 15&22, T19N, R18W

In Sept. 1995 Found Concrete Monument. Found no other evidence to dispute this location. Condition of the Recorded Witnesses are as follows:


- 16" Beech S-30°-W 19 lks (1) GONE
- 8" Hemlock N-23°-E 24 lks (2) GONE
- Cherry West 29.40' (3) FOUND
- 10" Apple Southeast 23.35' (4) GONE
- Power Pole Northwest 44.40' (5) FOUND

C. Description of monument for corner and accessories established to perpetuate locating the position of the corner:

H-7 QUARTER CORNER FOR SECTION 15 & 22, T19N, R18W

1995 accepted 4" x 36" Round concrete monument with cap as a careful and faithful perpetuation of the position of the original corner.

#5 P.Pole S-20°-W 44.42' #3, 18" W. Cherry N-81°-W 29.40'
 13" B. Oak S-67°-E 29.59' 10" W. Cherry N-22°-E 72.82'

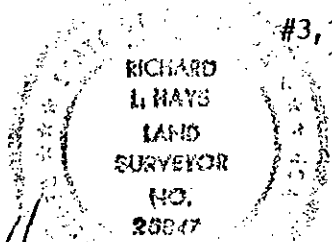

Signed by Richard Hays Date October 17, 1995
 Surveyor's Michigan License No. 25847

Peer Group Reviewed and Approved
 Date: 10-17-95
 Kenneth L. Ross
 Mason County Surveyor

FORM APPROVED BY MICHIGAN STATE BOARD OF PROFESSIONAL SURVEYORS, JAN. 28, 1971
 REVISED MAY 14, 1975
 REVISED JAN., 1983