


DEC 18 1995

COMMISSION

LAND CORNER RECORDATION CERTIFICATE

Filing Requirement of Act 74, Mich. P.A. 1970

For corners in Mason (County)	Located In:	Corner Code #
1. Public Land Survey	T 19N R 18W	H-11
	T ___ R ___	_____
	T ___ R ___	_____
	T ___ R ___	_____
2. Property Controlling in Section	S ___ T ___ R ___	_____
	S ___ T ___ R ___	_____
3. Miscellaneous Property in Section	S ___ T ___ R ___	_____
	S ___ T ___ R ___	_____

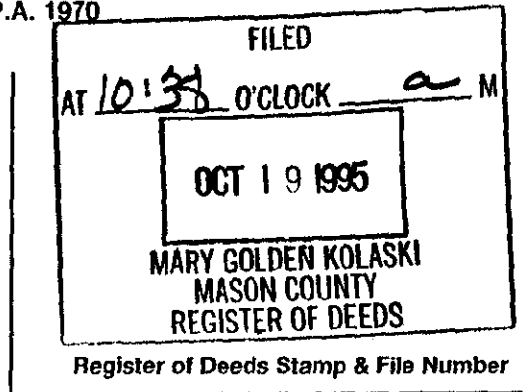

4. Lot No. _____, Recorded Plat _____
5. Private Claims _____

	A	B	C	D	E	F	G	H	I	J	K	L	M
2	6		5		4		3		2		1		
3													
4	7		8		9		10		11		12		
5													
6	18		17		16		15		14		13		
7													
8	19		20		21		22		23		24		
9													
10	30		29		28		27		26		25		
11													
12	31		32		33		34		35		36		
13													

I, Richard Hays, in a field survey on September, 1995, do hereby certify that under requirements of P.A. 74, Michigan P.A. of 1970, the corner points mentioned in lines 1 and 2 above were in conformance with regulations and rules therefore as required in the current manual of survey instructions of the United States Department of the Interior, Bureau of Land Management or by a decree of a Court of Law and/or that the corner points mentioned in lines 3, 4 and 5 above were in conformance with the rules of the Michigan Board of Professional Surveyors or by a Decree of a Court of Law; established, re-established, monumented, re-monumented, recovered, found as expressed below:

NOTE: Not more than 4 corners, all in the same town and range, may be recorded on this certificate.

A. Description of original monument and accessories and/or subsequent restoration:

- H-11 QUARTER CORNER FOR SECTIONS 27,34, T19N, R18W
- | | | |
|-------------------------------|------------------------------|--|
| 1838 G.L.O. Sibley | 1963 M.C.R.C. 1/2" Pipe | 1973 Act 74, L. 1, Pg. 200 by Kenneth Ross #17634 Found 3/4" Iron Pipe |
| 1) 8" Beech N-7°-E 24' | 3) P. Pole SW 66.06' | 6) 10" Maple S-60°-E 78.85' |
| 2) 8" Beech S-7°-E 16' | 4) 12" Maple S-75°-E 78.84' | 7) P.Pole S-20°-W 66.02' |
| 1984 Survey Dunlap | 5) 12" Cherry N-30°-W 77.35' | 8) 10" Cherry N-31°-W 77.87' |
| 9) P.Pole S-34°-W 66.70' | | |
| 10) 12" Cherry N-30°-W 77.85' | | |
| 11) 14" Maple S-80°-E 78.87' | | |


B. Description of corner evidence found and/or method applied in restoring or reestablishing corner:

H-11 QUARTER CORNER FOR SECTIONS 27 & 34, T19N, R18W
On Sept. 21, 1995 found 3/4" pipe no other evidence found to dispute this location.
Condition of Recorded Witnesses is #1 Gone, #2 Gone, #3 Found, #4 Found, #5 Found, #6 Found, #7 Found, #8 Gone, #9 Found, #10 Gone, #11 Found

C. Description of monument for corner and accessories established to perpetuate locating the position of the corner:

H-11 QUARTER CORNER FOR SECTION 27 & 34, T19N, R18W
Replaced 3/4" Iron Pipe with a 5/8" Re-Rod 24" long with an aluminum cap stamped Mason County Monument; and is accepted as a careful and faithful reestablishment to the position of the original corner.

- | | | |
|----|--------------------------|---------------------------|
| #3 | P.Pole S-37°-W 66.62' | Guy Pole N-81°-E 131.58' |
| #4 | 20" Maple S-70°-E 78.88' | 11" W. Oak N-32°-W 37.15' |

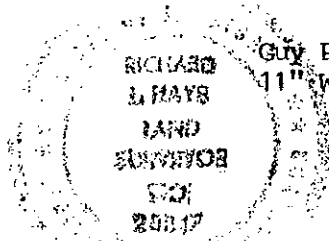

Signed by Richard Hays Date October 17, 1995

Surveyor's Michigan License No. 25847 Peer Group Reviewed and Approved Date: 10-17-95 FORM APPROVED BY MICHIGAN STATE BOARD OF PROFESSIONAL SURVEYORS, JAN. 28, 1971 REVISED MAY 14, 1975 REVISED JAN., 1983
Kerneth L. Ross
Mason County Surveyor