

DEC 18 1995

COMMISSION

LAND CORNER RECORDATION CERTIFICATE
Filing Requirement of Act 74, Mich. P.A. 1970

For corners in

Mason Located In: _____ Corner Code #/ _____
(County)


1. Public Land Survey T 19N R 18W H-13
T _____ R _____
T _____ R _____
T _____ R _____

2. Property Controlling S _____ T _____ R _____
in Section S _____ T _____ R _____

3. Miscellaneous S _____ T _____ R _____
Property in Sec. S _____ T _____ R _____

4. Lot No. _____, Recorded Plat _____

5. Private Claims _____

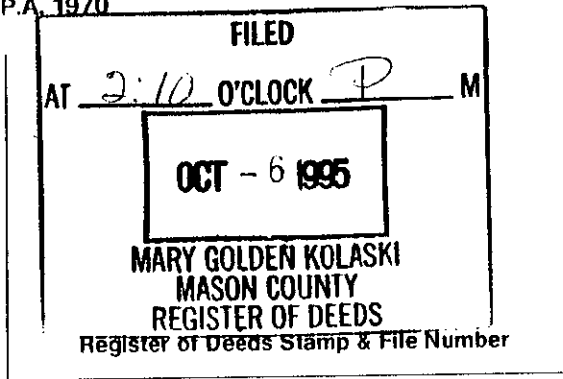

	A	B	C	D	E	F	G	H	I	J	K	L	M
2	6	5	4	3	2	1							
3													
4	7	8	9	10	11	12							
5													
6	18	17	16	15	14	13							
7													
8	19	20	21	22	23	24							
9													
10	30	29	28	27	26	25							
11													
12	31	32	33	34	35	36							
13													

I, Richard Hays in a field survey on September, 1995, do hereby certify that under requirements of P.A. 74, Michigan P.A. of 1970, the corner points mentioned in lines 1 and 2 above were in conformance with regulations and rules therefore as required in the current manual of survey instructions of the United States Department of the Interior, Bureau of Land Management or by a decree of a Court of Law and/or that the corner points mentioned in lines 3, 4 and 5 above were in conformance with the rules of the Michigan Board of Land Surveyors or by a Decree of a Court of Law; established, re-established, monumented, re-monumented, recovered, found as expressed below:

NOTE: Not more than 4 corners, all in the same town and range, may be recorded on this certificate.

A. Description of original monument and accessories and/or subsequent restoration:
H-13 QUARTER CORNER COMMON TO SECTION 34.
 1838:G.L.O. Survey
 6" Beech N-80°-W 11 Lks (1)
 8" Beech N-60°-E 50 Lks (2)

1973:MASON COUNTY ROAD COMMISSION 1-1/2" Iron Pipe in Monument Box
 36" Red Oak Northeast 54.17' (3)
 NE Cor. Garage Apron Northwest 95.41' (4)
 Power Pole Southeast 59.02' (5)

B. Description of corner evidence found and/or method applied in restoring or reestablishing corner:
H-13 QUARTER CORNER COMMON TO SECTION 34.
 1995:Found 1-1/2" Iron Pipe in Monument box. Found no other evidence to dispute this location. Condition of the Recorded Witnesses are as follows:
 6" Beech N-80°-W 11 Lks (1) GONE
 8" Beech N-60°-E 50 Lks (2) GONE
 36" Red Oak Northeast 54.17' (3) FOUND
 NE Cor. Garage Apron Northwest 95.41' (4) FOUND
 Power Pole Southeast 59.02' (5) FOUND

C. Description of monument for corner and accessories established to perpetuate locating the position of the corner:

H-13 QUARTER CORNER COMMON TO SECTION 34.
 1995:Placed 5/8" Re-Rod with an Aluminum Cap stamped MASON COUNTY MONUMENT inside the 1-1/2" Iron Pipe in Monument Box and is accepted as a careful and and faithful perpetuation of the position of the Original Corner.
 40" Red Oak N-23°-E 54.15' (3)
 Power Pole S-59°-E 58.70' (5)
 28" B. Oak S-28°-W 69.30'
 Power Pole N-42°-W 44.18'

North Quarter Corner of Section 03
 Monument Box East 21.40'

Signed by Richard Hays Date September 28, 1995

Surveyor's Michigan License No. 25847
 Peer Group Reviewed and Approved
 Date: 9-28-95
Kenneth I. Ross
 Mason County Surveyor

