

DEC 18 1995

COMMISSION

LAND CORNER RECORDATION CERTIFICATE

Filing Requirement of Act 74, Mich. P.A. 1970

For corners in

Mason Located In: Corner Code #1

- 1. Public Land Survey T 19N R 18W I-3
- 2. Property Controlling in Section S T R
- 3. Miscellaneous Property in Sec. S T R

- 4. Lot No. Recorded Plat
- 5. Private Claims

I, **Richard Hays**, in a field survey on **September**, 19**95** do hereby certify that under requirements of P.A. 74, Michigan P.A. of 1970, the corner points mentioned in lines 1 and 2 above were in conformance with regulations and rules therefore as required in the current manual of survey instructions of the United States Department of the Interior, Bureau of Land Management or by a decree of a Court of Law and/or that the corner points mentioned in lines 3, 4 and 5 above were in conformance with the rules of the Michigan Board of Land Surveyors or by a Decree of a Court of Law; established, re-established, monumented, re-monumented, recovered, found as expressed below:

NOTE: Not more than 4 corners, all in the same town and range, may be recorded on this certificate.

A. Description of original monument and accessories and/or subsequent restoration:


I-3 SECTION CORNER COMMON TO SECTIONS 2, 3 & 10 & 11
 1838:G.L.O. Survey 1907:John A. Mitchell Survey 1970:MASON COUNTY ROAD COMMISSION
 8" Beech N-07°-E 11 Lks(1) Book 2, Page 59 (3) Conc. Mon. SE 46.80'
 8" Beech S-40°-W 25 Lks(2) Set Iron No Witnesses (4) 16" Maple NE 61.40'
 1889:Highway Survey by John A. Mitchell 1955:Plat of Rednalis Subdivision No Witnesses.

B. Description of corner evidence found and/or method applied in restoring or reestablishing corner:

I-3 SECTION CORNER COMMON TO SECTIONS 2, 3 & 10 & 11
 1995:Found Monument Box with a 2"x2" shaft. Found no other evidence to dispute this location. Condition of Recorded Witnesses are as follows:
 8" Beech N-07°-E 11 Lks (1) GONE
 8" Beech S-40°-W 25 Lks (2) GONE
 Conc. Mon. SE 46.80' (3) FOUND
 16" Maple NE 61.40' (4) FOUND

C. Description of monument for corner and accessories established to perpetuate locating the position of the corner:

I-3 SECTION CORNER COMMON TO SECTIONS 2, 3 & 10 & 11
 1995:Replaced 2"x2" Shaft with a 5/8" Re-Rod, 24" long with an Aluminum Cap stamped MASON COUNTY MONUMENT and is accepted as a careful and faithful perpetuation of the position of the Original Corner.
 36" Maple N-25°-E 62.35' (4)
 Tel. Pole N-20°-W 86.40'
 9" Apple S-38°-W 57.05'
 Power Pole S-52°-E 45.42'

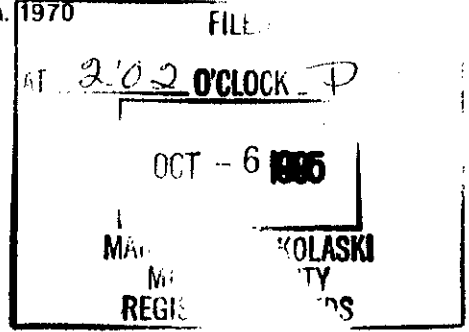

	A	B	C	D	E	F	G	H	I	J	K	L	M
2	6		5		4		3		2		1		
3													
4	7		8		9		10		11		12		
5													
6	18		17		16		15		14		13		
7													
8	19		20		21		22		23		24		
9													
10	30		29		28		27		26		25		
11													
12	31		32		33		34		35		36		
13													

Signed by Richard Hays Date September 28, 1995
 Surveyor's Michigan License No. 25847
 Peer Group Reviewed and Approved Date: 9-28-95
 Kenneth L. Ross
 Mason County Surveyor

